


17 LONGITUDINAL SECTION SCALE 1/8" = 1'-0"

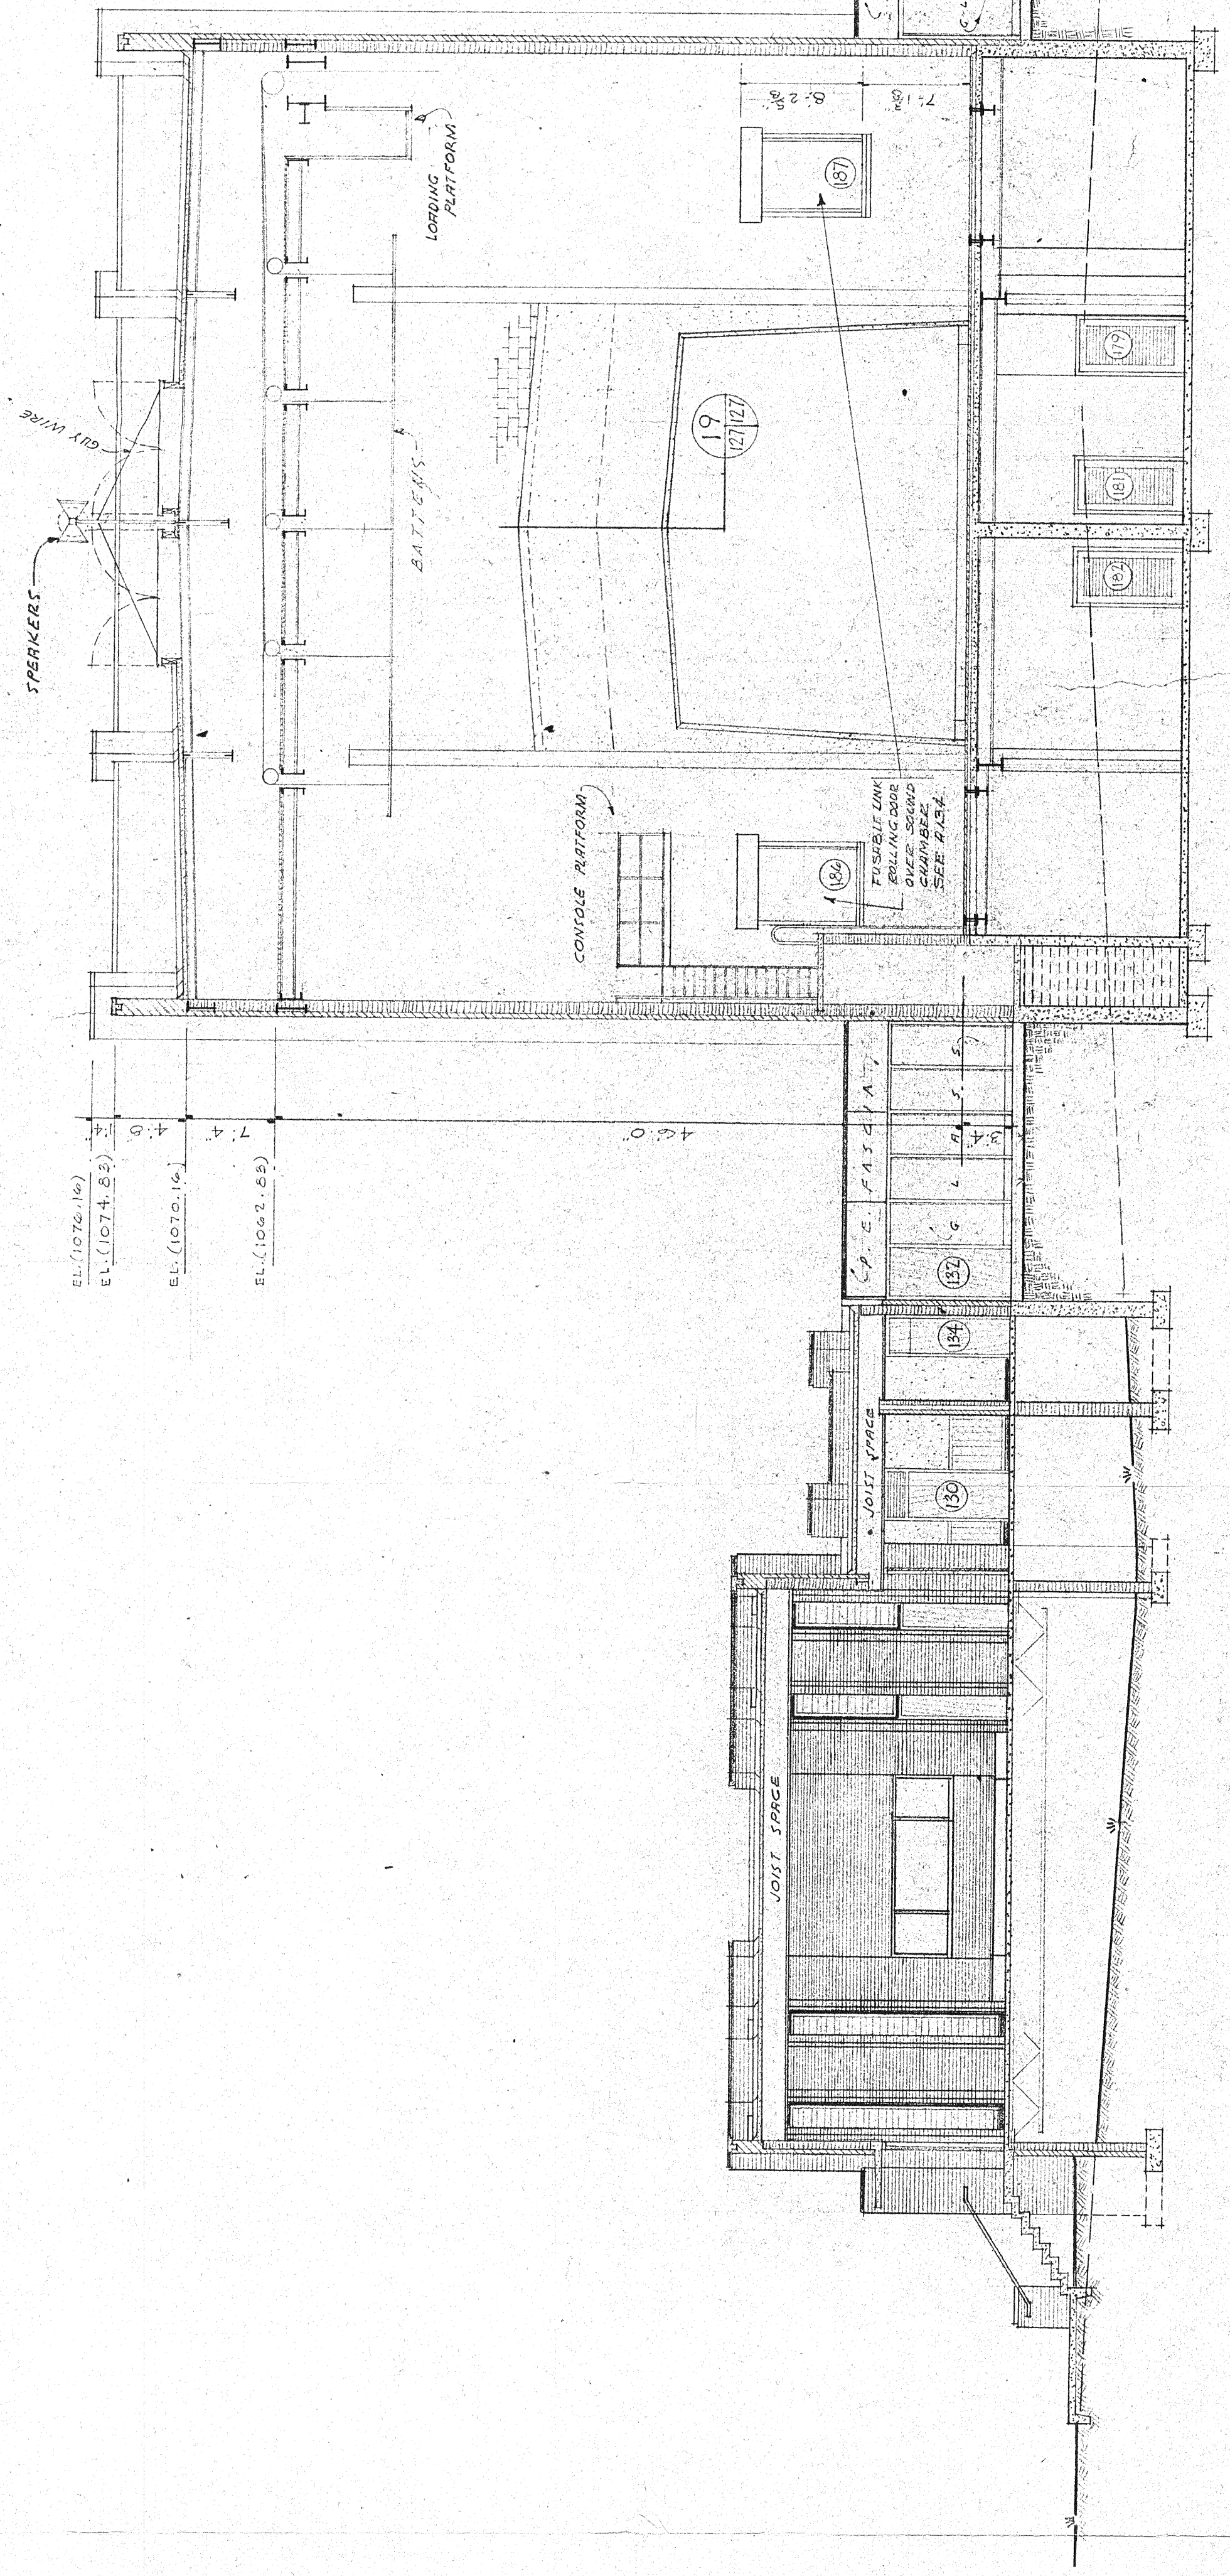

18 CROSS SECTION SCALE 1/8" = 1'-0"

DATE	REVISION	DESCRIPTION	BY
5/28/70	1	CHANGED TO AS-BUILT DRAWINGS	

GEORGIA RETARDATION CENTER  
 DEKALB COUNTY, GEORGIA  
 GEORGIA DEPARTMENT OF PUBLIC HEALTH  
**BUILDING L**

LONGITUDINAL & CROSS SECTIONS  
 DWG. NO. **A-127**  
 DSN. R.F.C.  
 DWN. G.R.P.  
 CHK. M.K.J.  
 AUGUSTA, GEORGIA  
 JOB NO. 655  
 DATE FEB. 1966  
 REVISION NO. OF 195

