




53 SECTION OF STAIR - SPACE L-152
SCALE 1/2" = 1'-0"

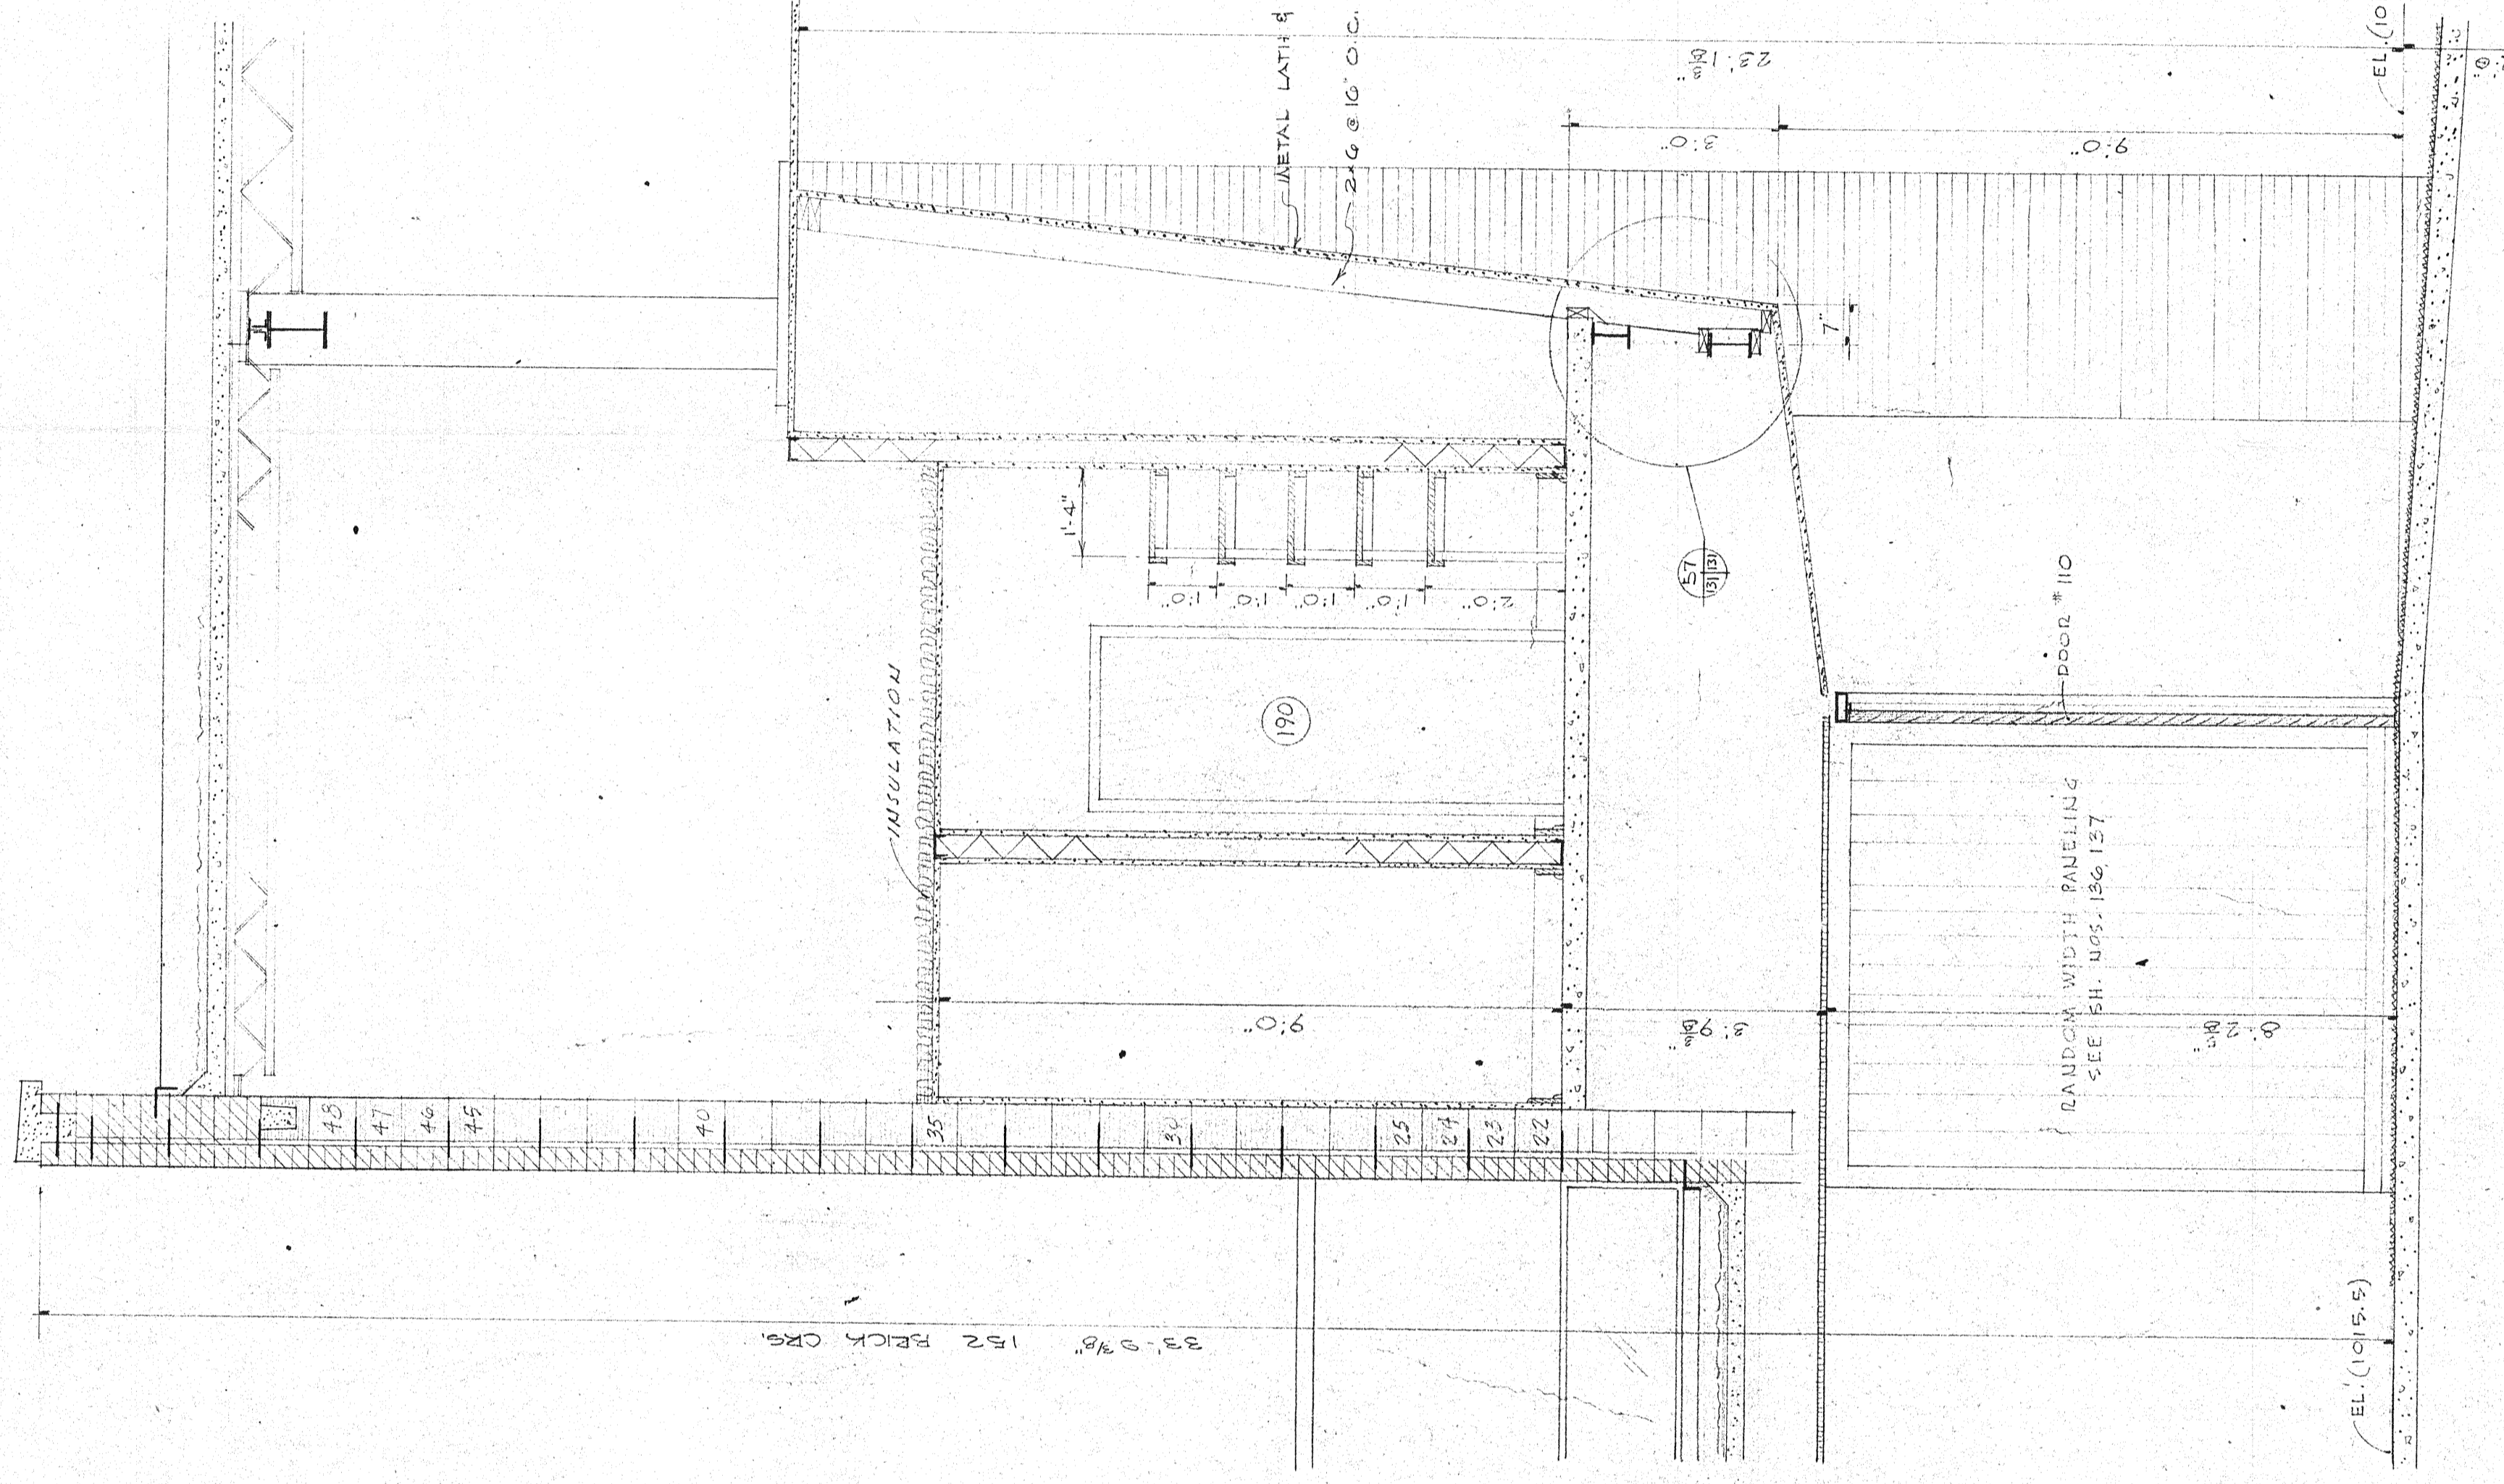


54 SIDE ENTRANCE FROM FOYER L-145 TO AUDITORIUM L-143
SCALE 1/2" = 1'-0"

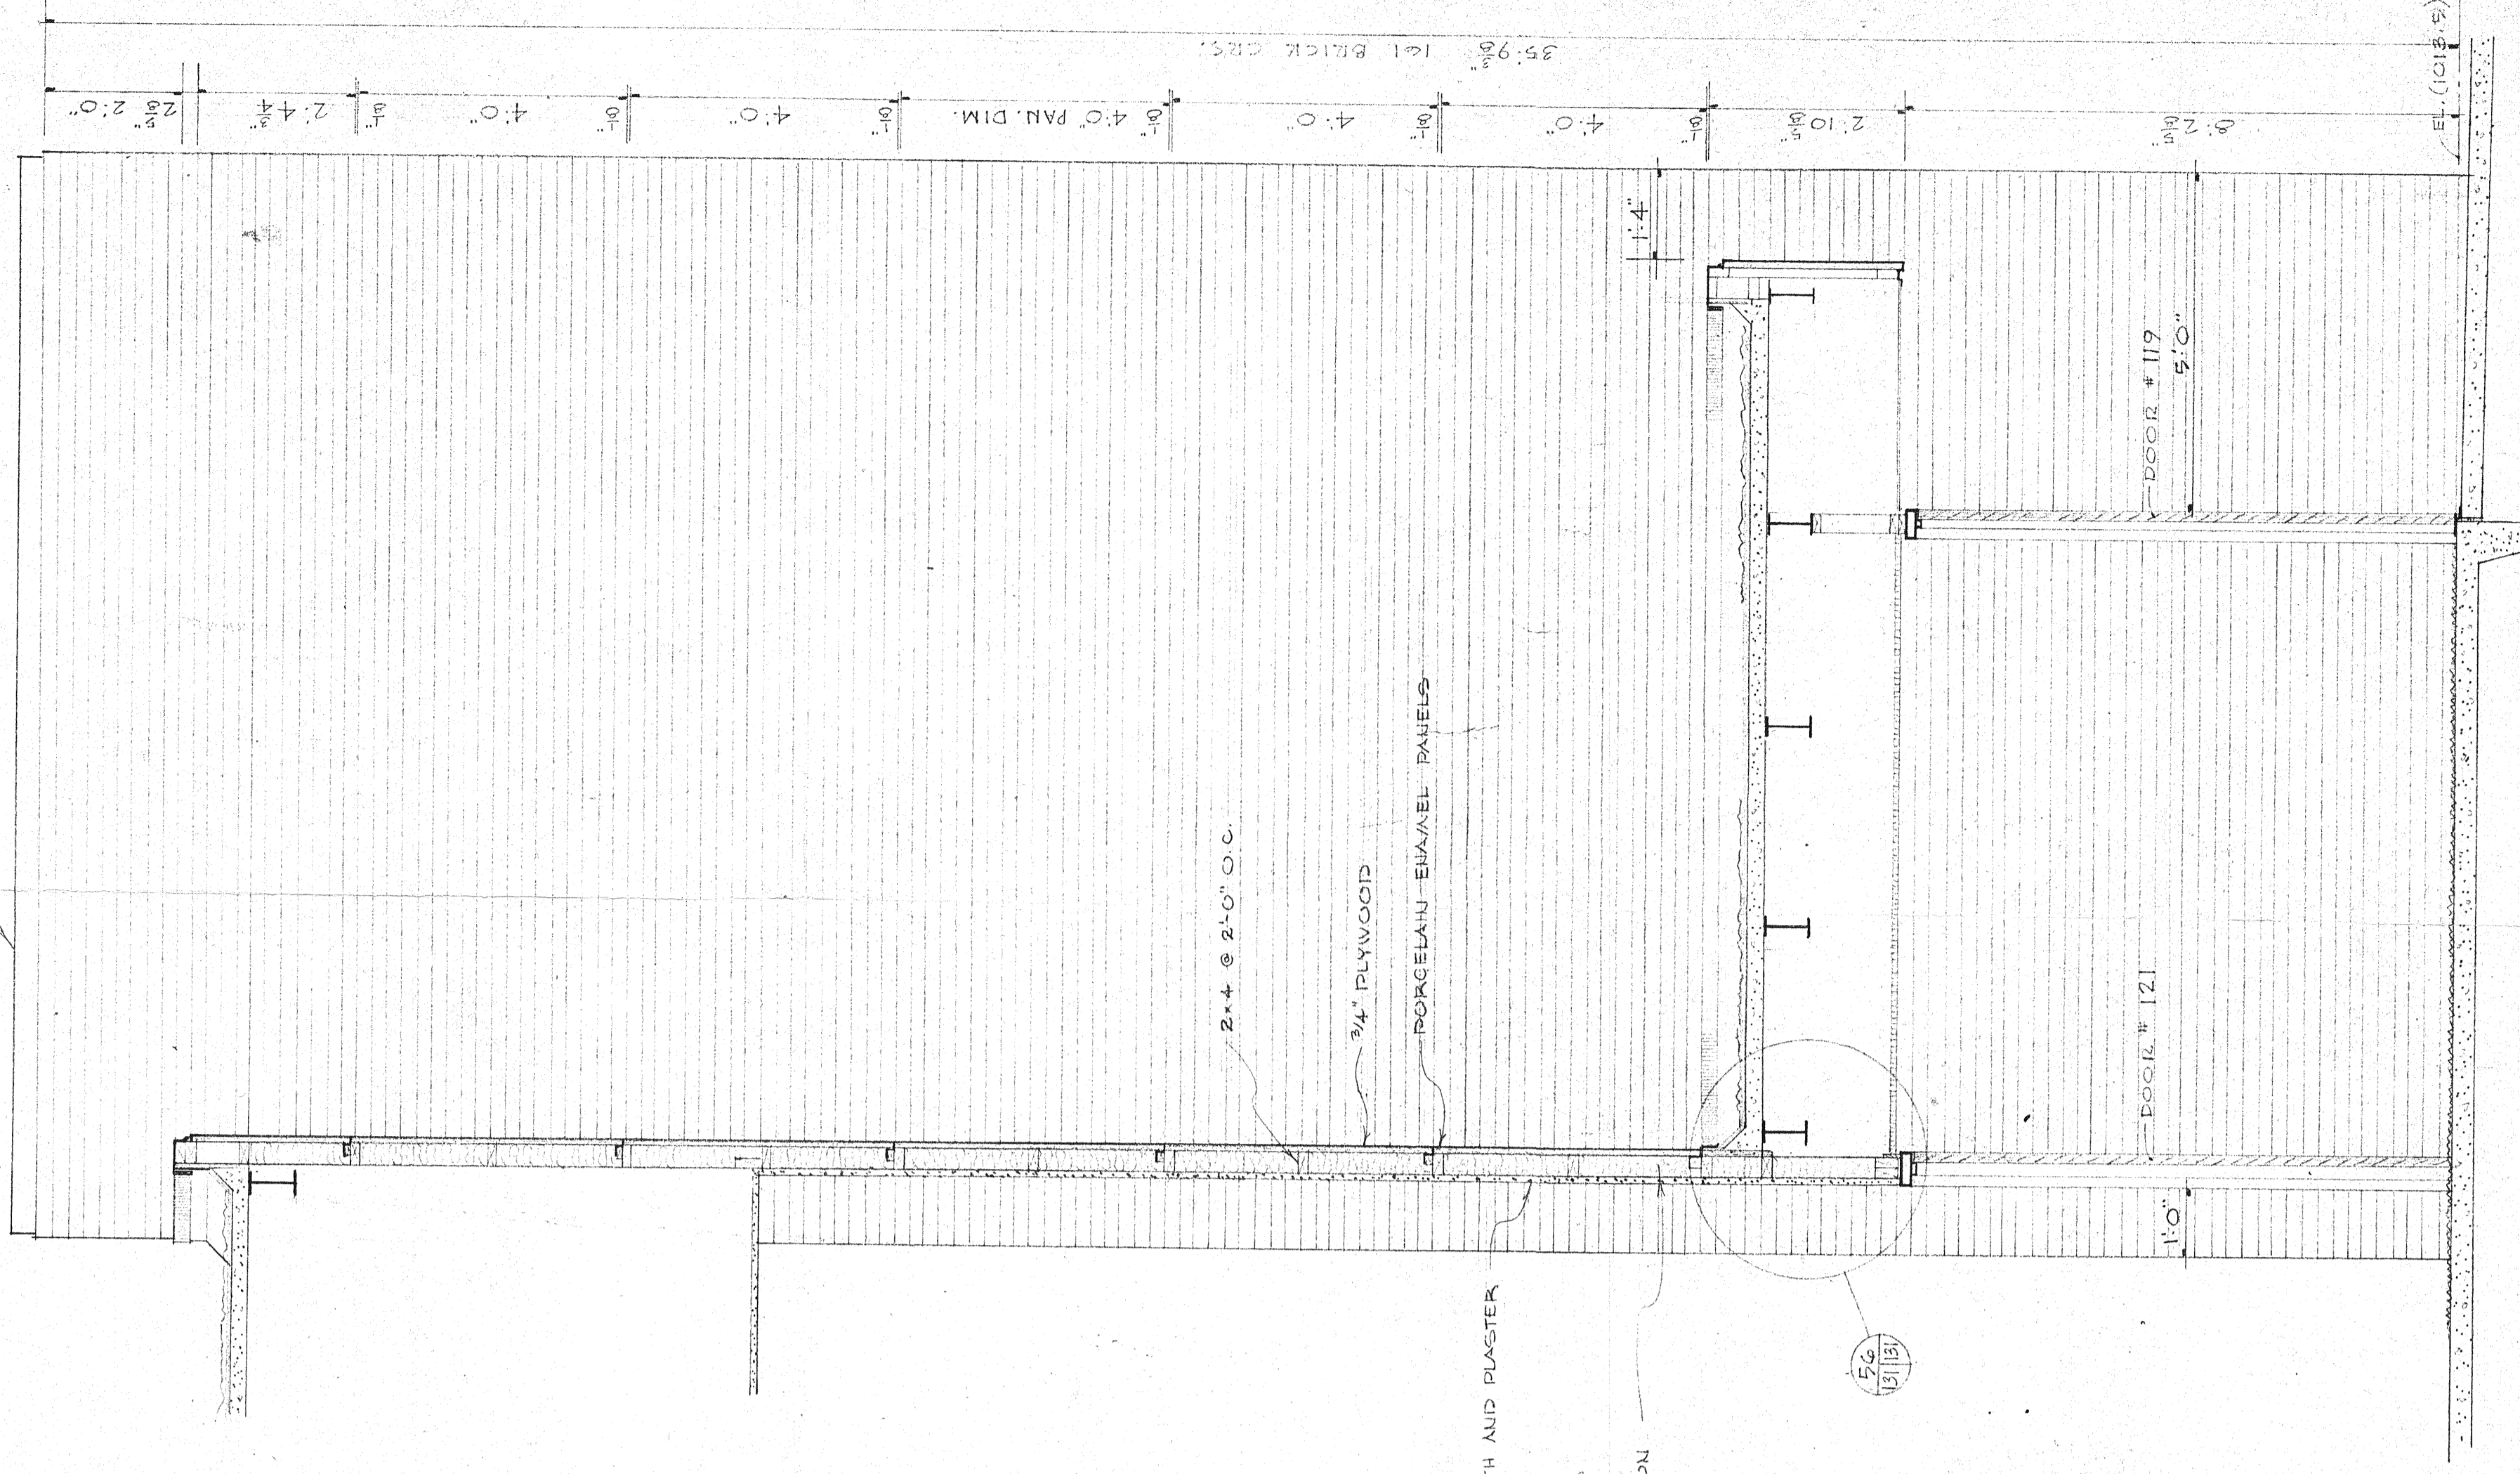

55 ENTRANCE TO CORRIDOR L-105
SCALE 1/2" = 1'-0"

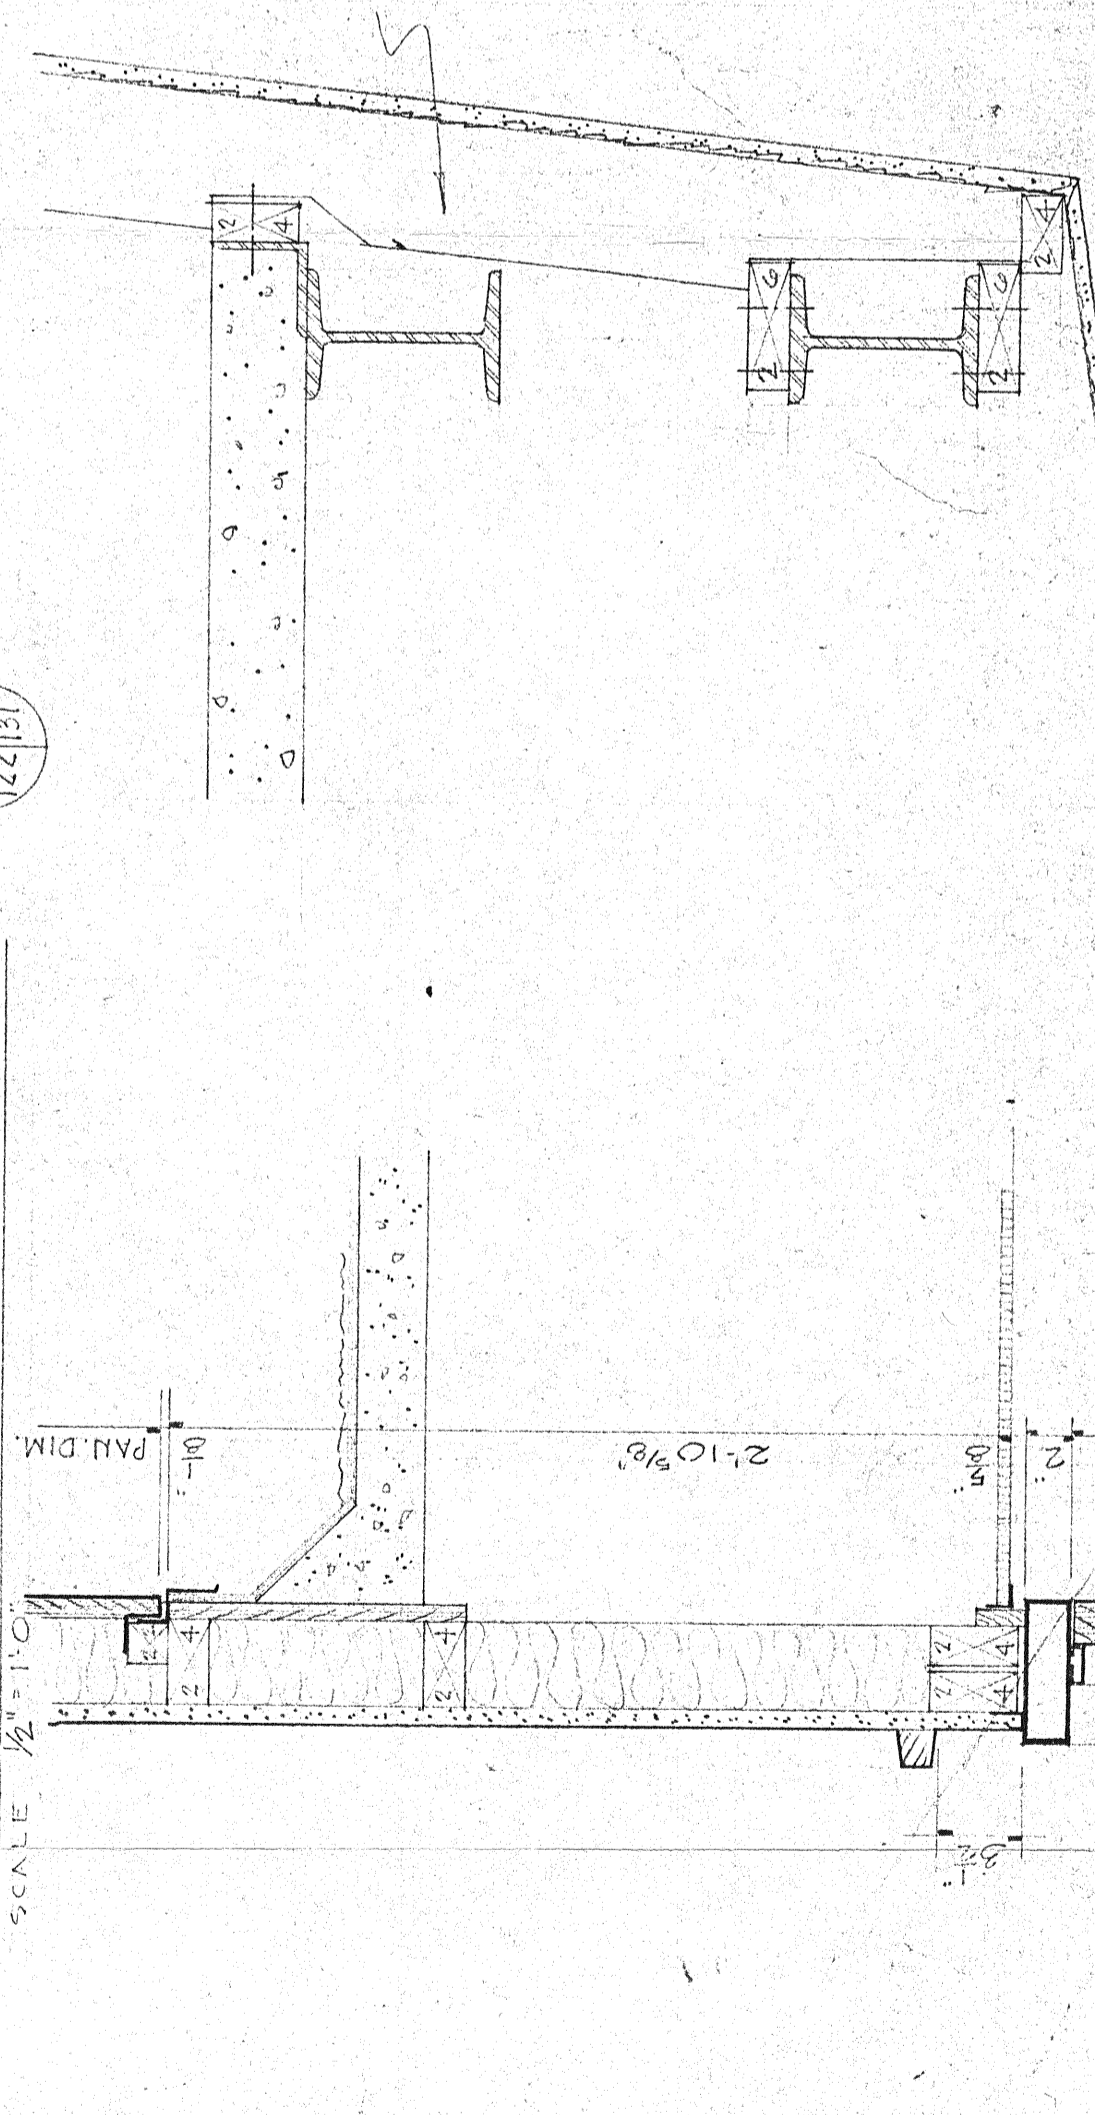

56 HEAD OF DR. NOS. 121, 122
SCALE 1/2" = 1'-0"

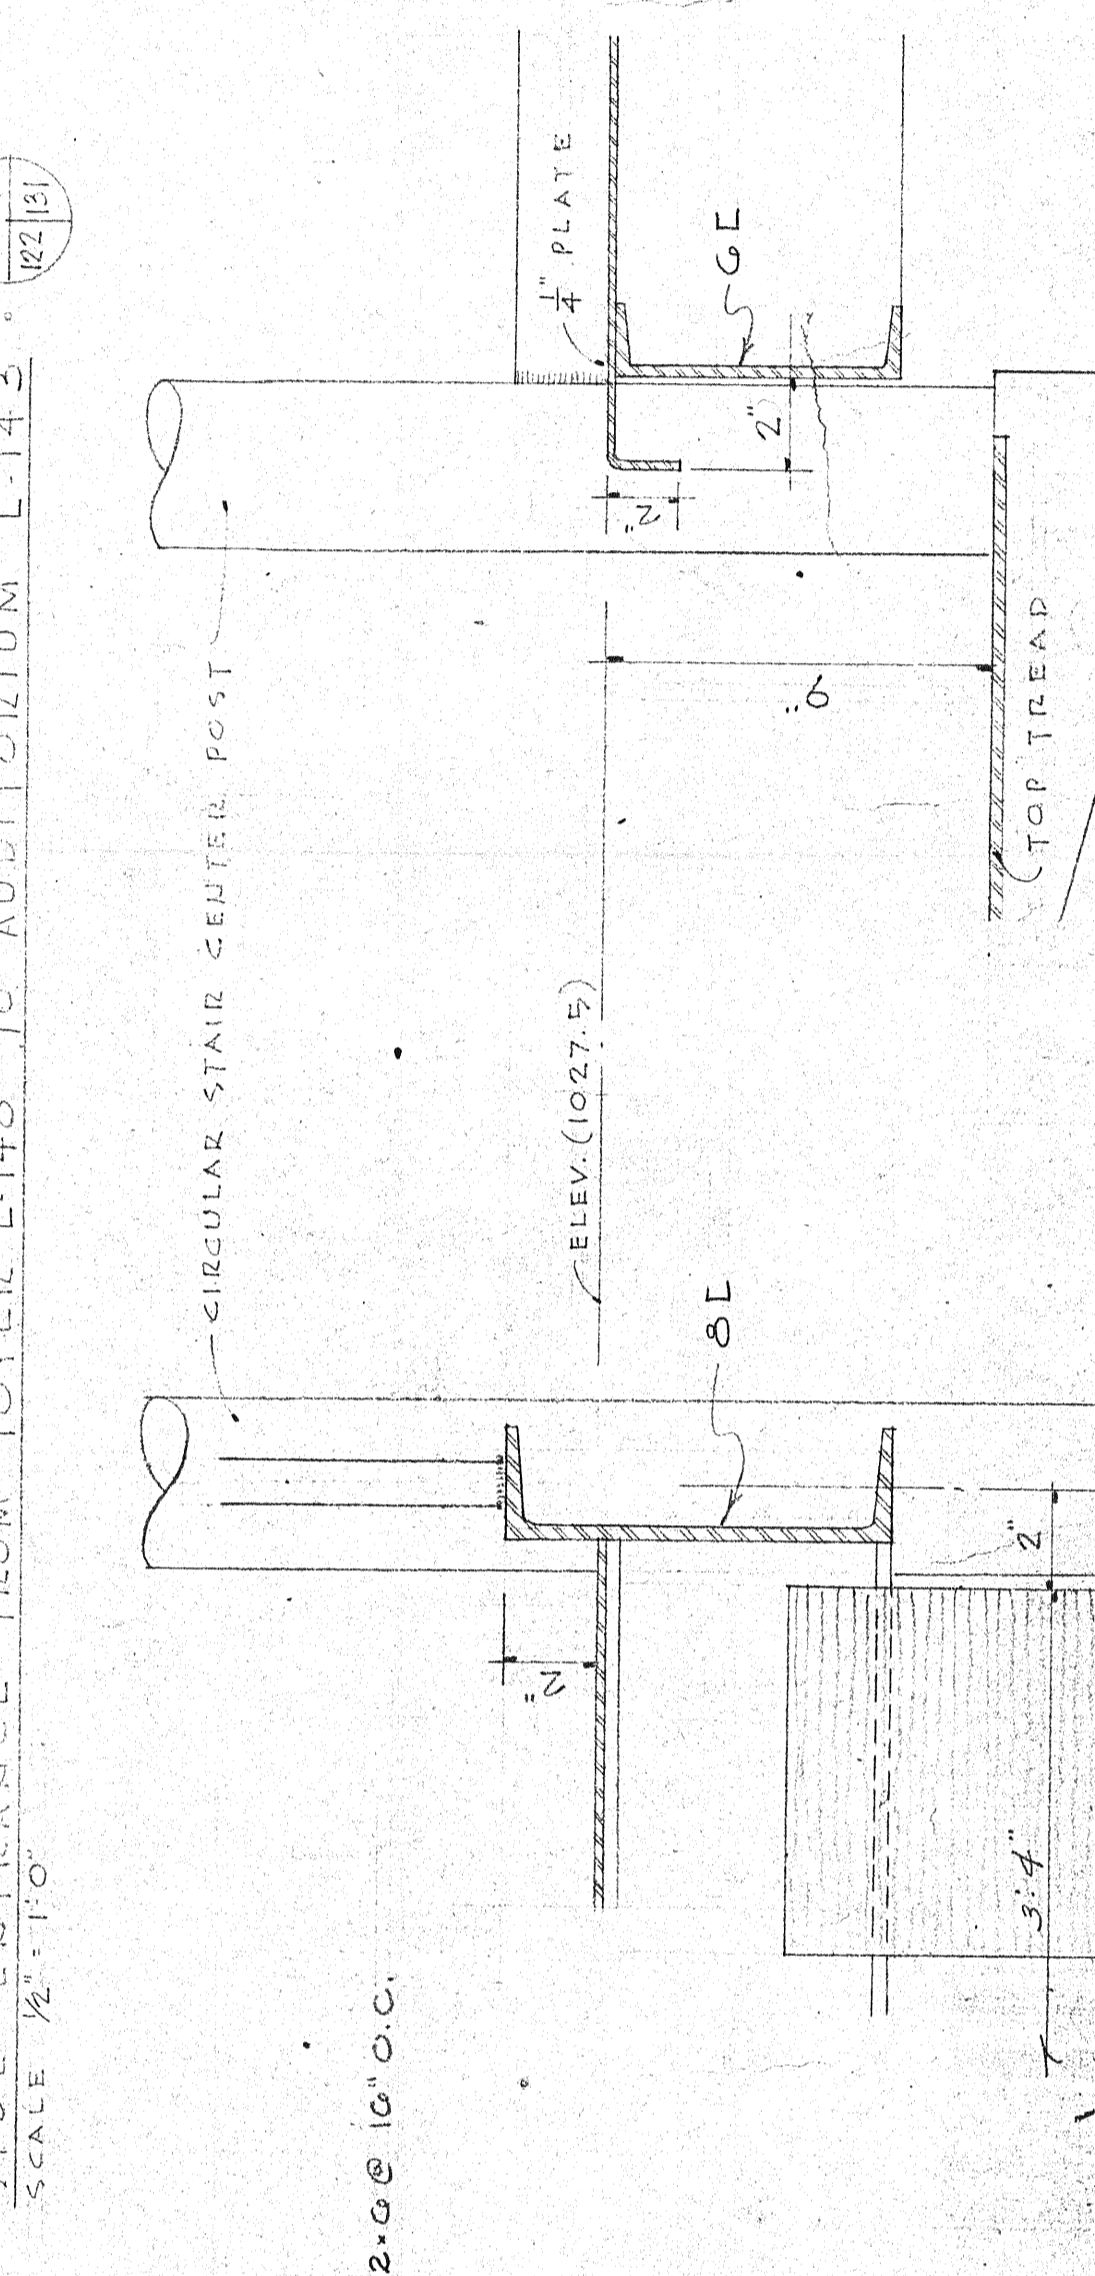

58 STAIR LANDING & RAILING
SCALE 3/4" = 1'-0"




59 LANDING & CIRCULAR STAIR
SCALE 3/4" = 1'-0"

CONC. COPING, PAINT FACE BLACK

DATE	REVISION	DESCRIPTION	BY
8/29/70	1	CHANGED TO AS BUILT DRAWINGS	BY

NOTES: ALL BLOCK COURSES ARE NUMBERED FROM EACH (1618.5)

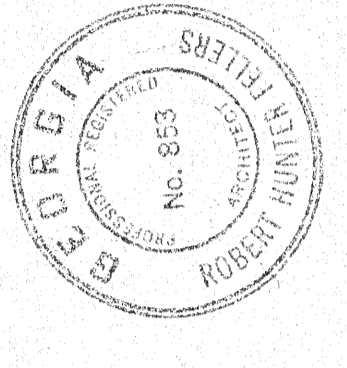

GEORGIA RETARDATION CENTER
DEKALB COUNTY, GEORGIA
GEORGIA DEPARTMENT OF PUBLIC HEALTH

BUILDING L

ARCHITECTS AND ASSOCIATES
WALL SECTIONS - AUDITORIUM
APPROVED BY
D.S.K. L.R.F.
D.W.N. G.R.P.
C.H.K. M.K.J.
AUGUSTA, GEORGIA
JOB NO. 655
DATE FEB. 1966
REVISION NO. OF 195

DWG. NO. A-131