

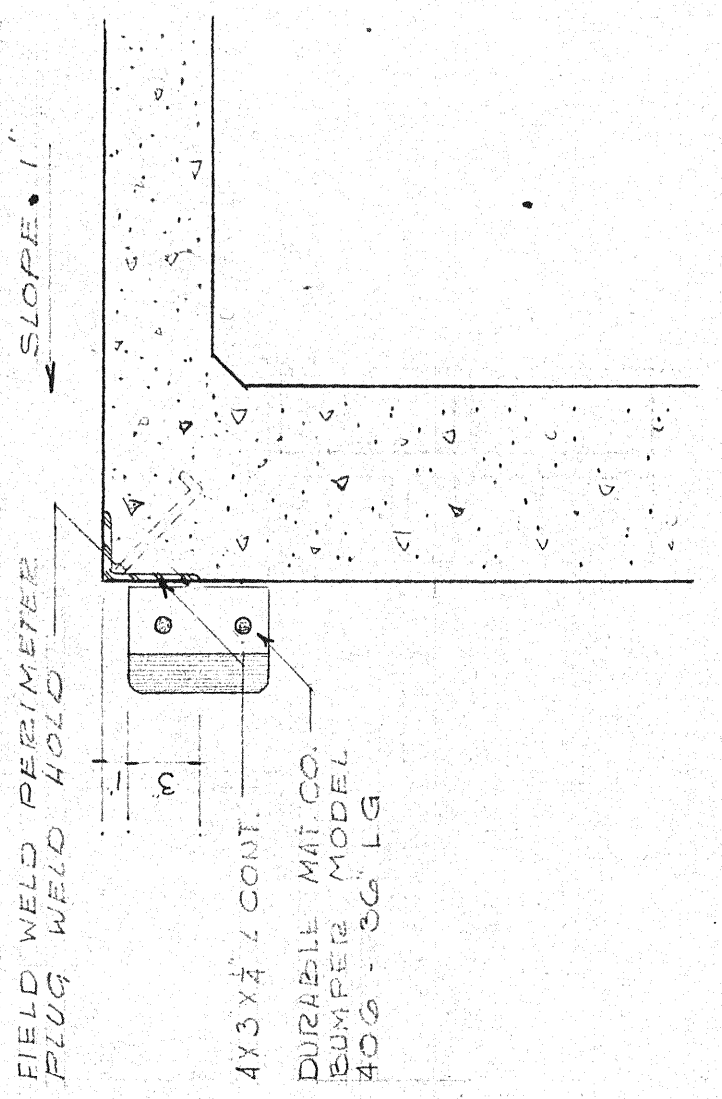
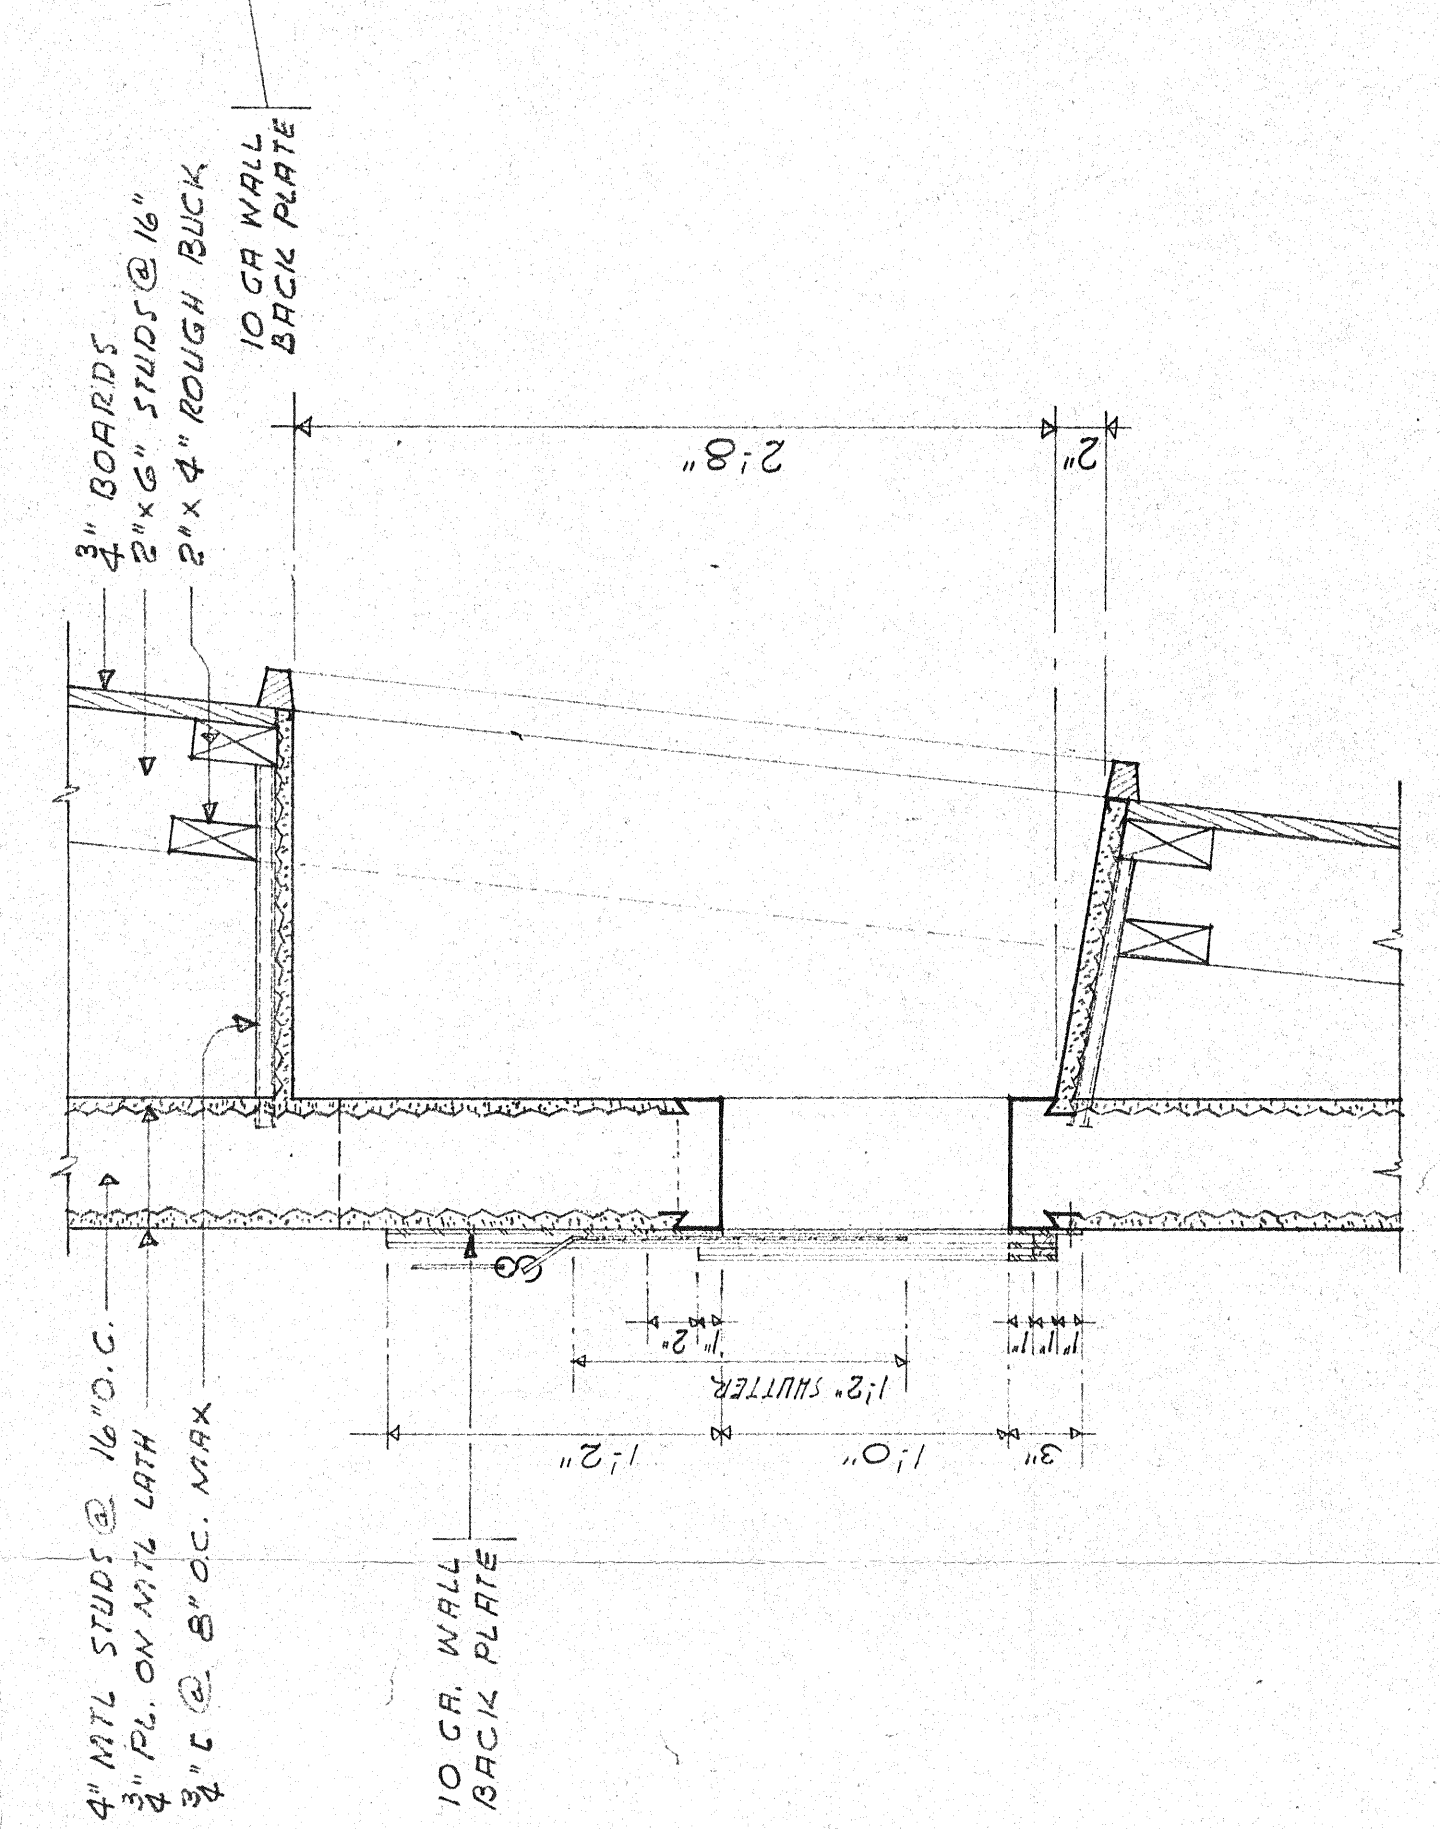



ELEVATION OF PROJECTION ROOM PORTS
SCALE 2" = 1'-0"

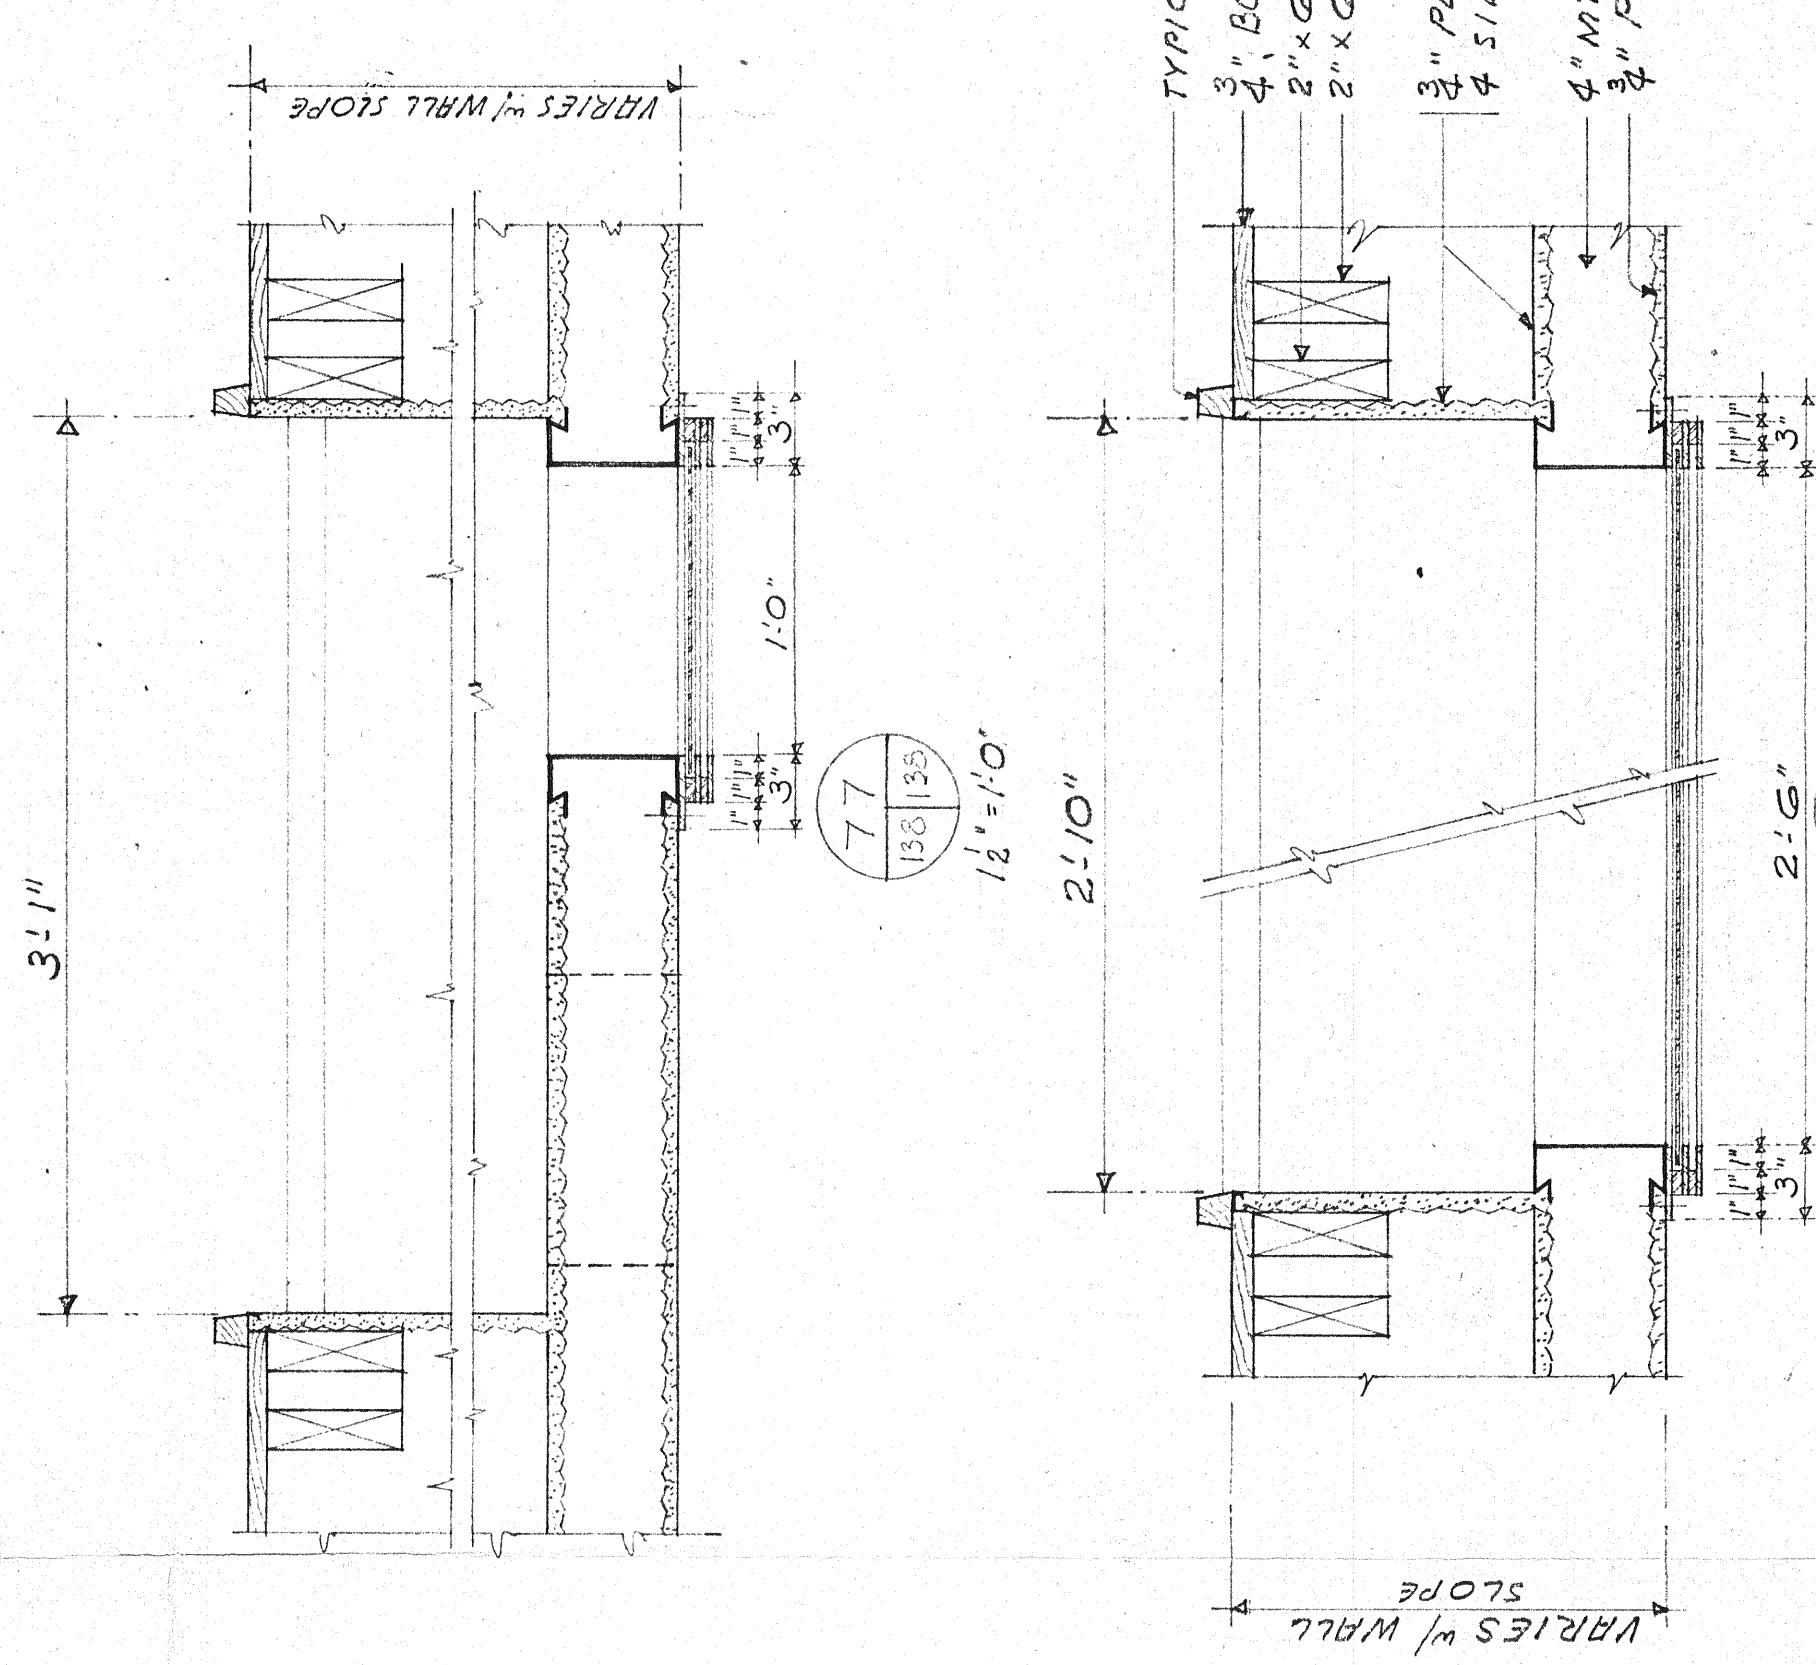

DETAIL of PLATFORM BUMPER
SCALE 1/2" = 1'-0"

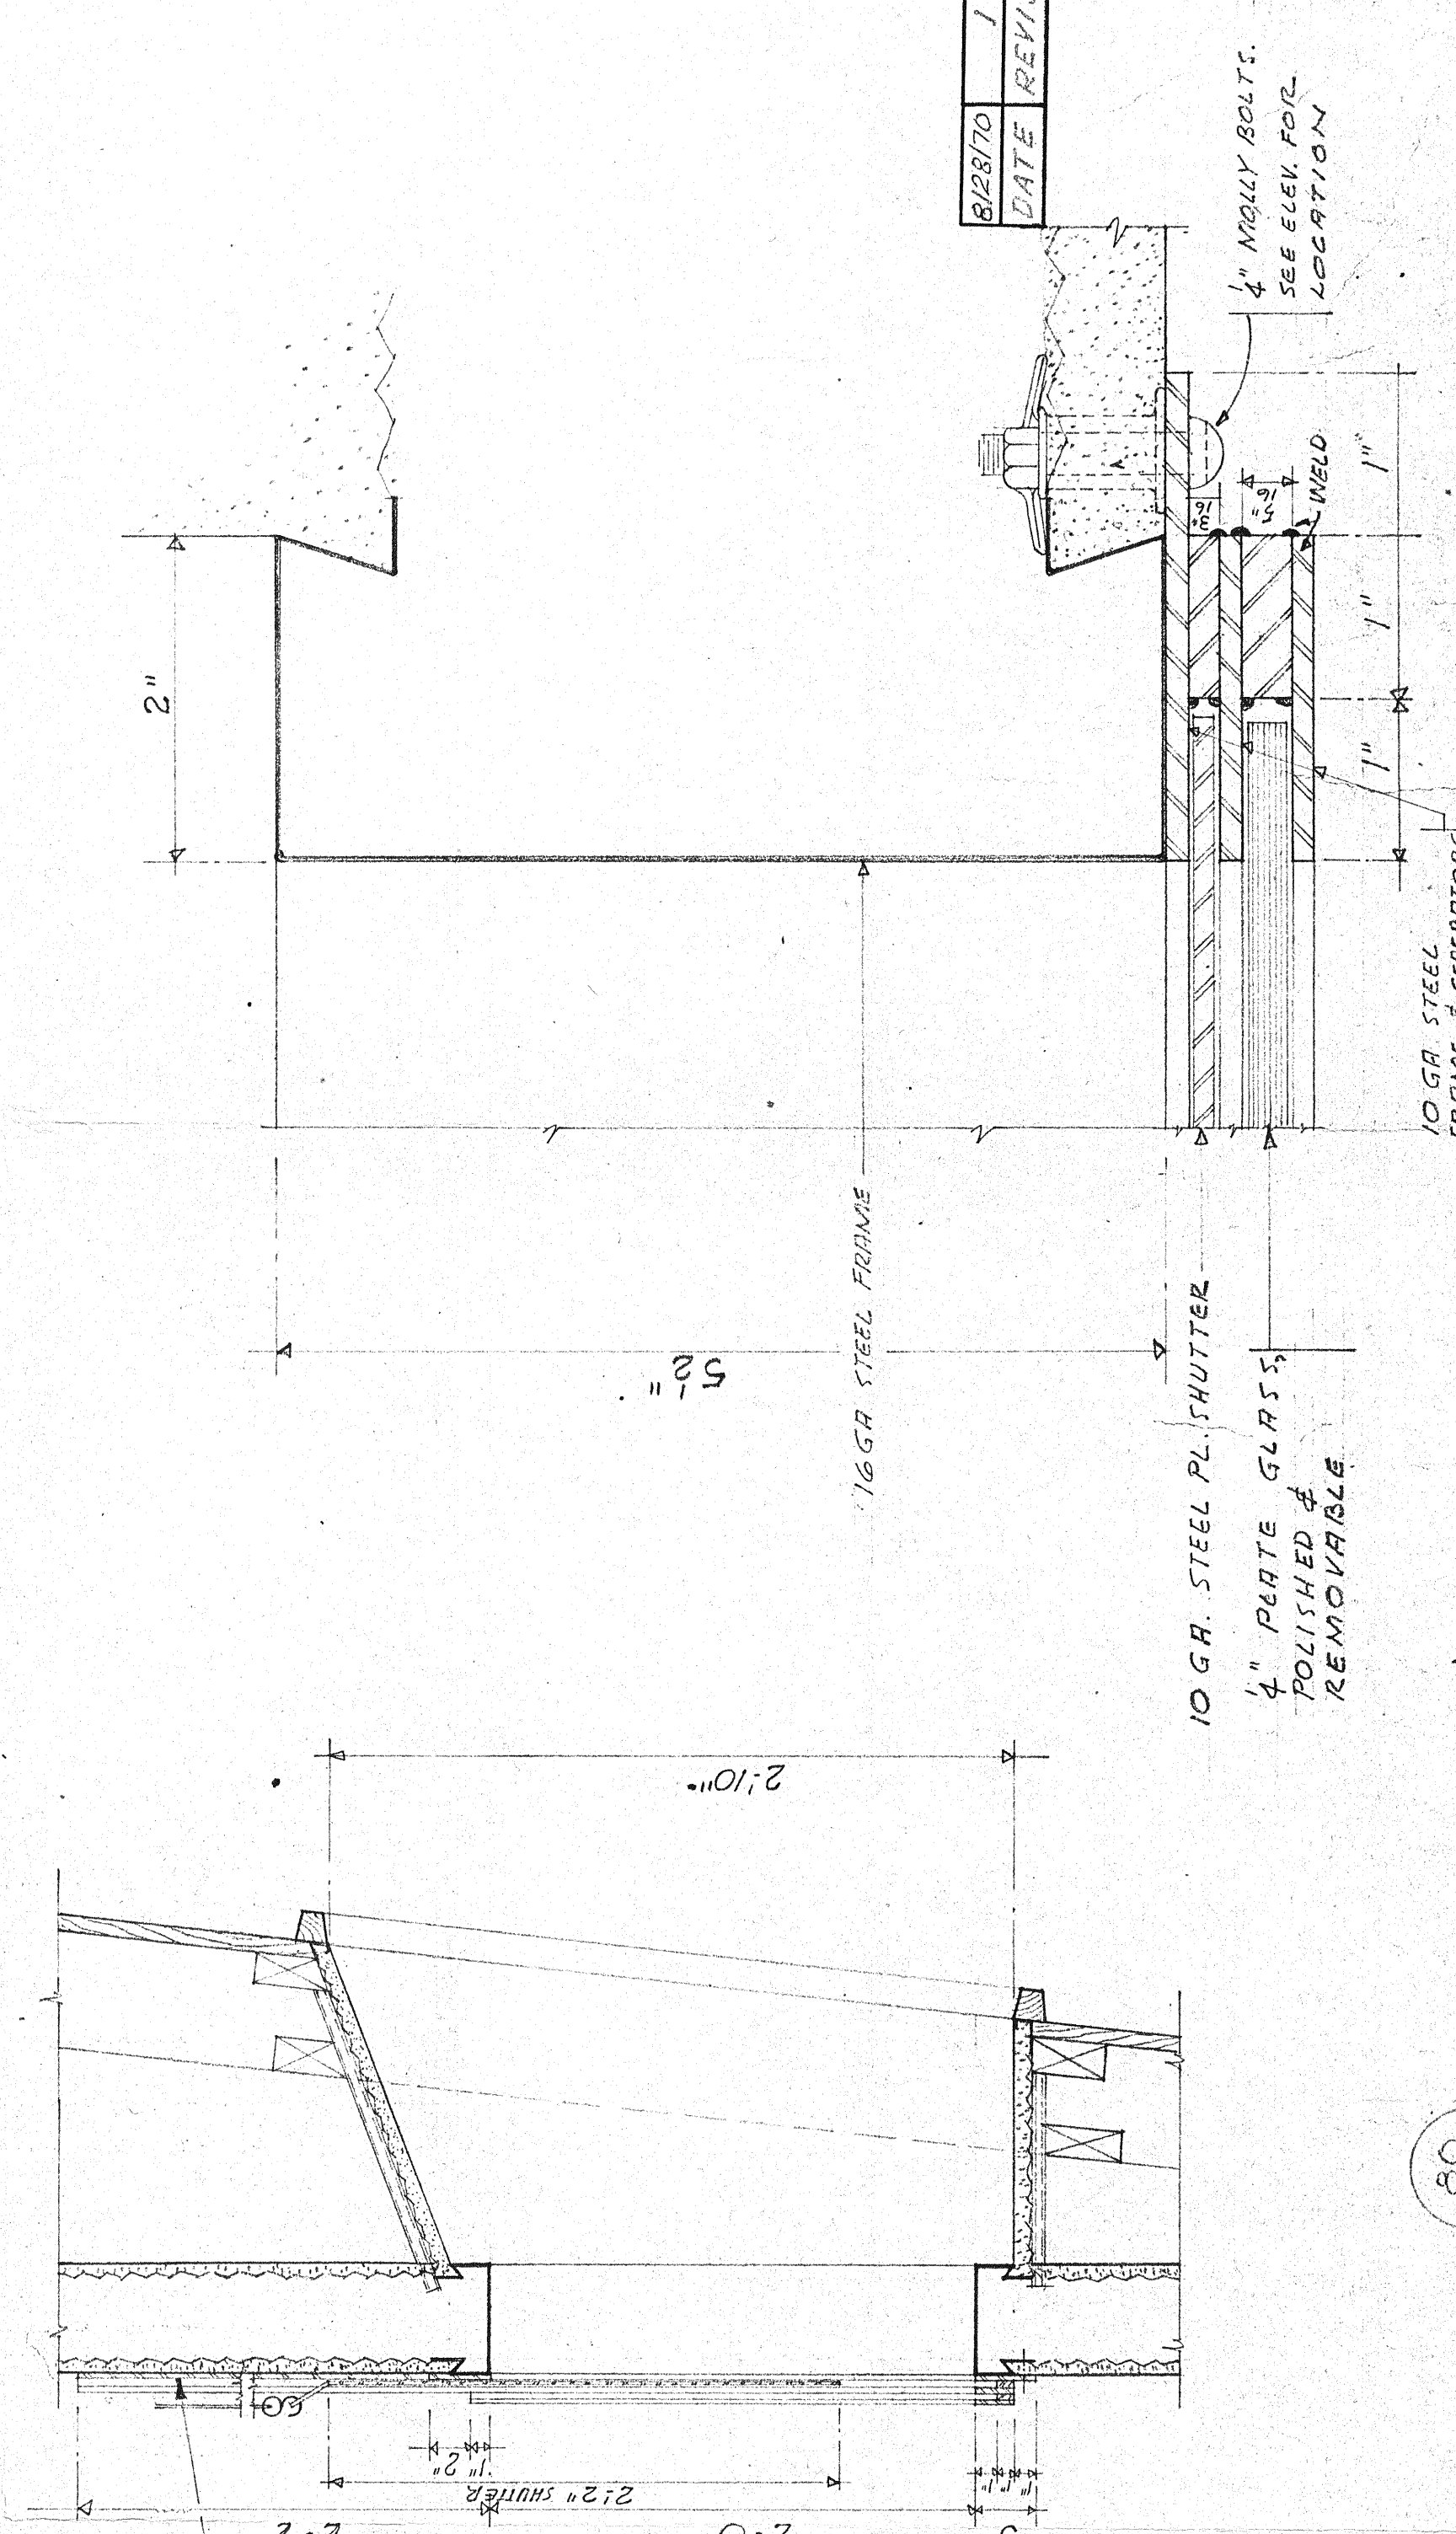

FULL SIZE PORT JAMB DETAIL
(SILL DETAIL SIMILAR - HEAD DETAIL SIMILAR EXCEPT 10 GA. WALL BACK PLATE WELDED TO 3\"/>

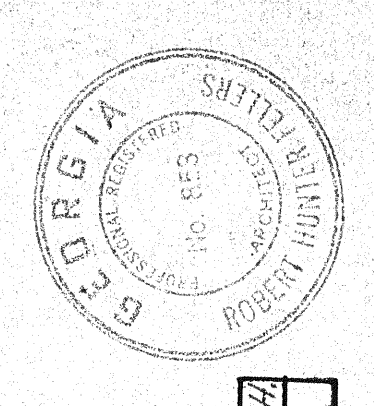

DATE	REVISION	DESCRIPTION	BY
6/28/70	1	CHANGE TO AS BUILT DRAWINGS	W.F.M.

JONES AND ASSOCIATES
 ARCHITECTS AND ENGINEERS
 AUGUSTA, GEORGIA

GEORGIA RETARDATION CENTER
 DEKALB COUNTY, GEORGIA
 GEORGIA DEPARTMENT OF PUBLIC HEALTH

BUILDING L

PROJECTION BOOTH & MISC DETAILS

DESIGNED BY: J.L.B.
 DRAWN BY: J.L.B.
 CHECKED BY: M.K.J.
 DATE: FEB 1966
 REVISION NO: 685

DWG. NO. **A-138**
 OF 195