


AUDITORIUM LIGHTING SCHEDULE (HOUSE LIGHTS TO DIMMER CONSOLE)	
DIMMING CIRCUITS (H) SWITCHED CIRCUITS (A)	
H-1 900 W.	A-1 900 W.
H-2 900 W.	A-2 1200 W.
H-3 1200 W.	A-3 900 W.
H-4 1050 W.	A-4 1200 W.
H-5 1050 W.	

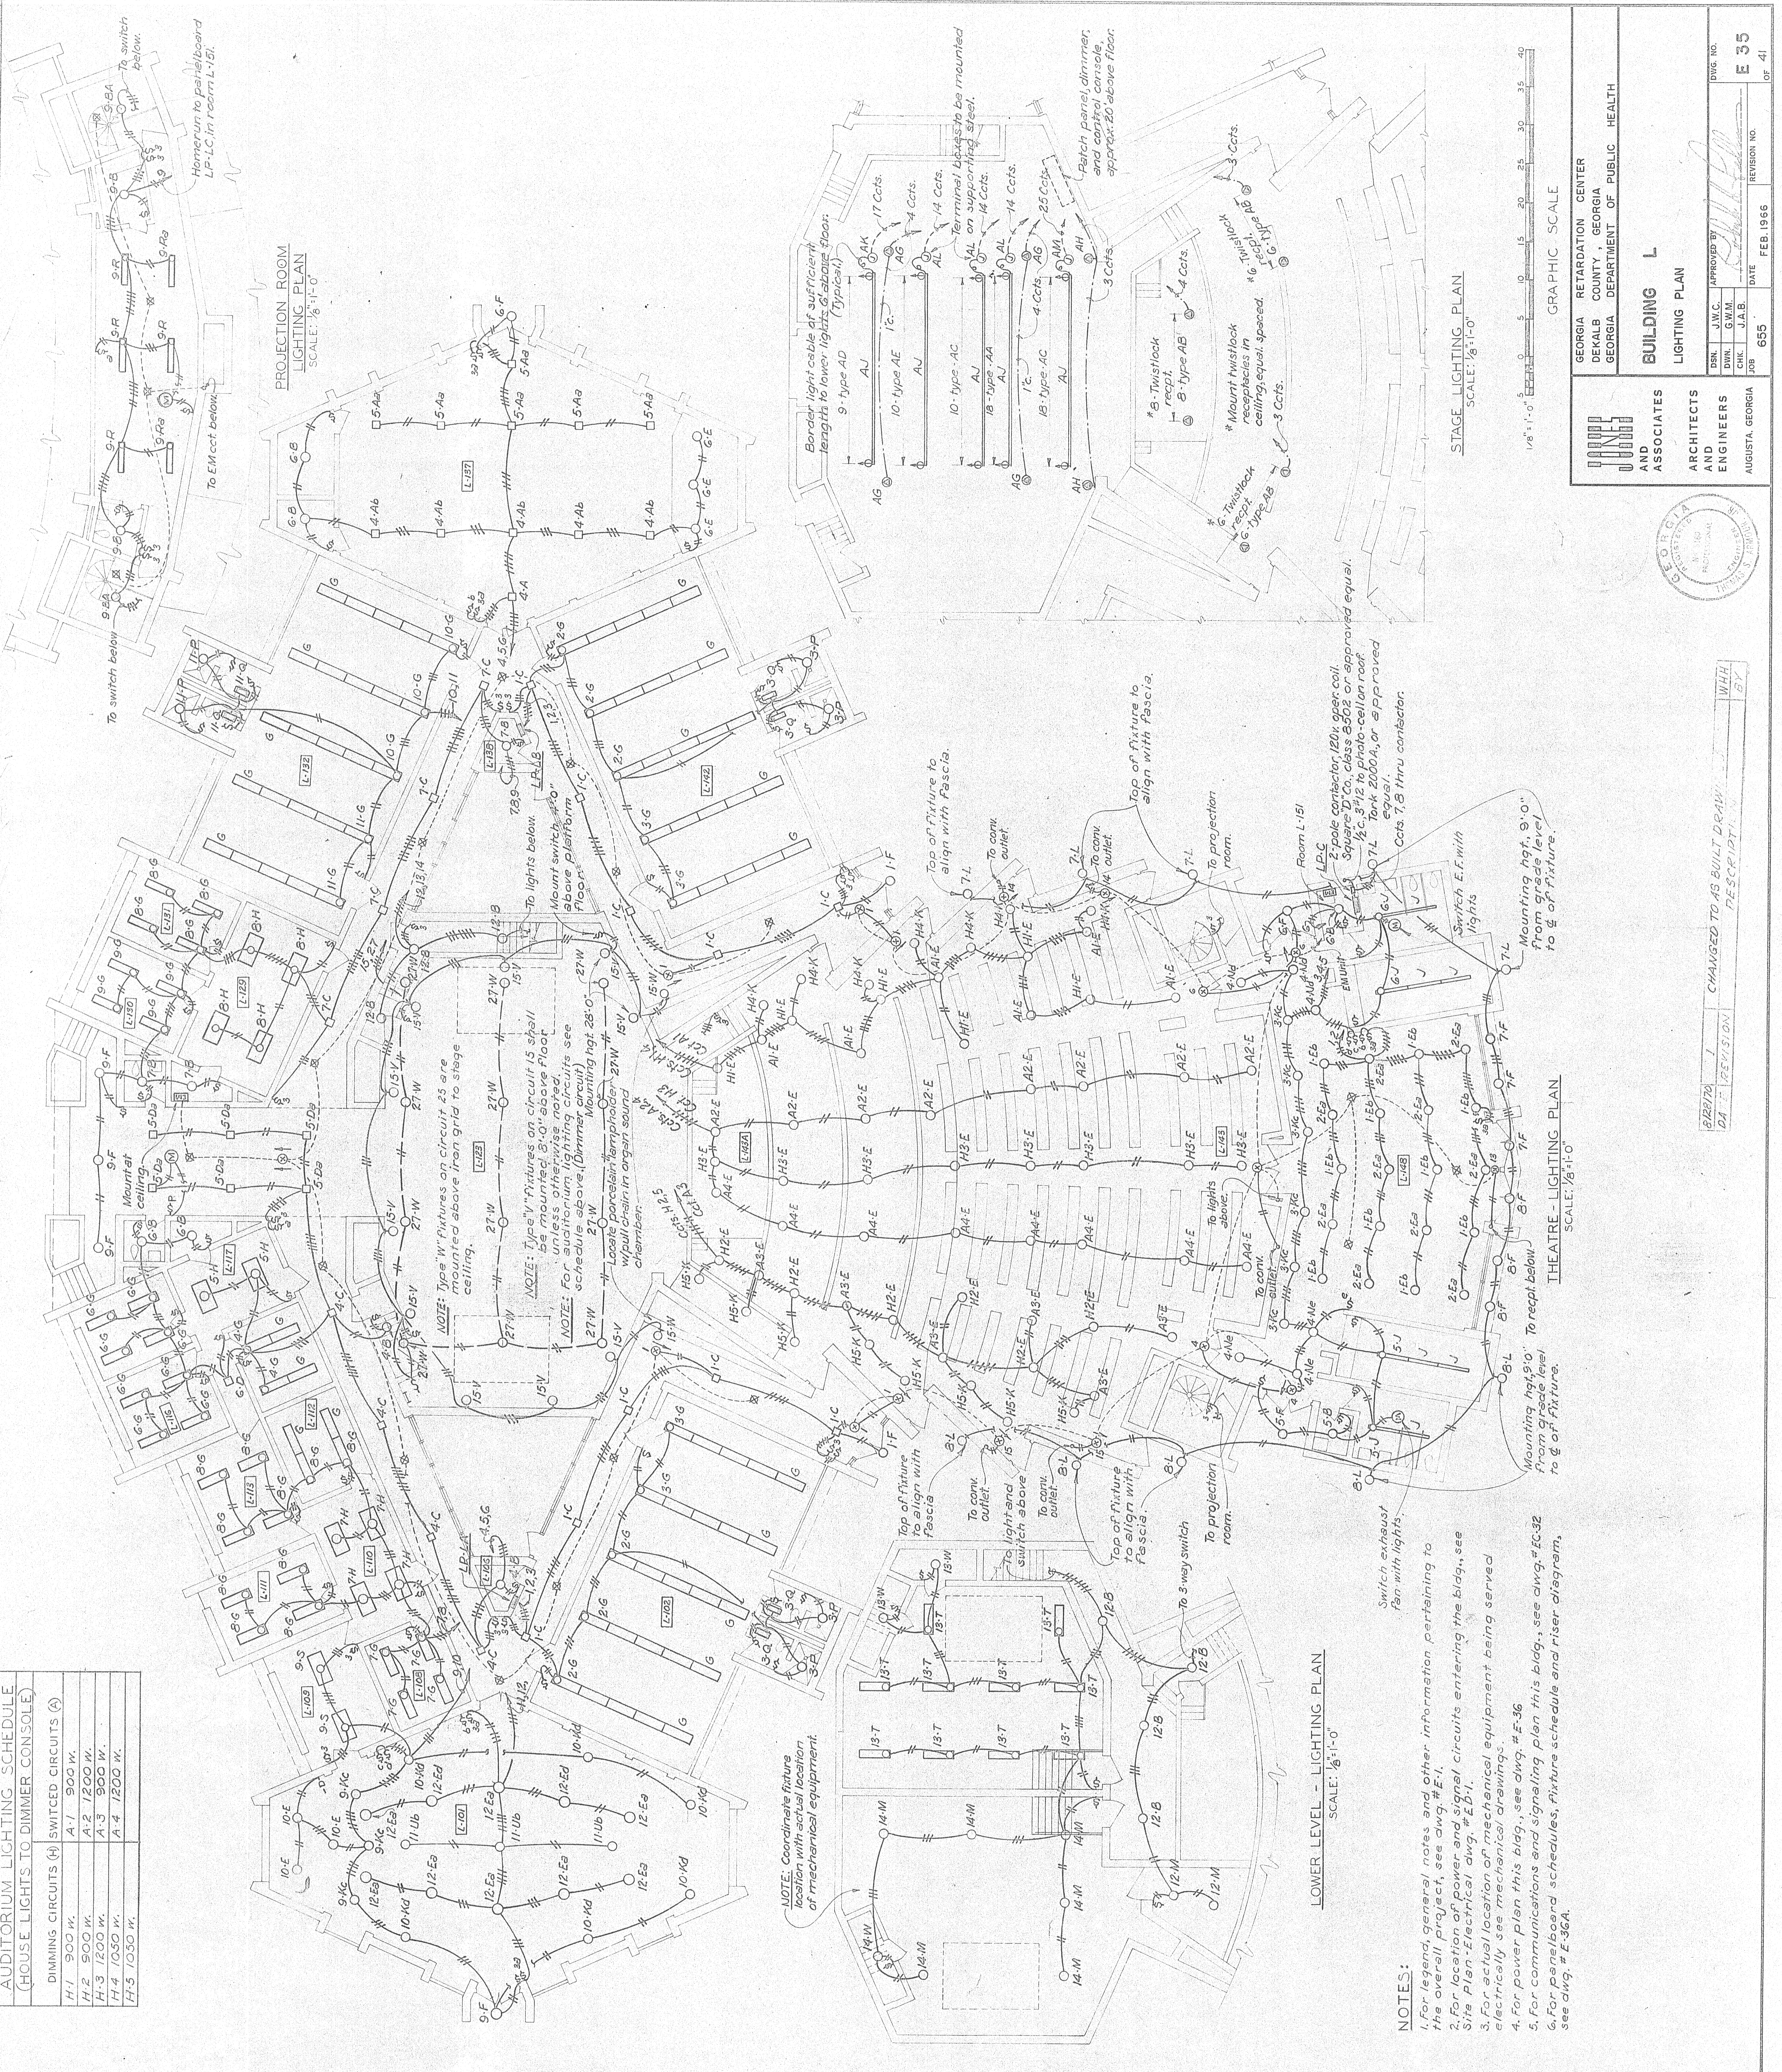


PROJECTION ROOM LIGHTING PLAN
SCALE: 1/8" = 1'-0"

STAGE LIGHTING PLAN
SCALE: 1/8" = 1'-0"

THEATRE - LIGHTING PLAN
SCALE: 1/8" = 1'-0"

LOWER LEVEL - LIGHTING PLAN
SCALE: 1/8" = 1'-0"

NOTES:
 1. For legend, general notes and other information pertaining to the overall project, see dwg. # E-1.
 2. For location of power and signal circuits entering the bldg., see Site Plan - Electrical dwg. # E-01.
 3. For actual location of mechanical equipment being served electrically see mechanical drawings.
 4. For power plan this bldg., see dwg. # E-36.
 5. For communications and signaling plan this bldg., see dwg. # EC-32.
 6. For panelboard schedules, fixture schedule and riser diagram, see dwg. # E-36A.

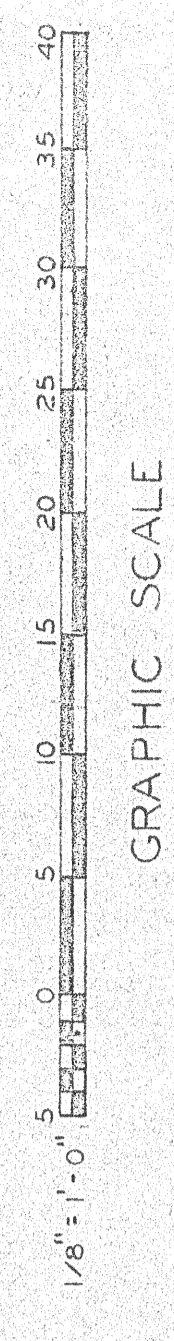

GEORGIA RETARDATION CENTER
 DEKALB COUNTY, GEORGIA
 GEORGIA DEPARTMENT OF PUBLIC HEALTH

BUILDING L
 LIGHTING PLAN

AND ASSOCIATES ARCHITECTS AND ENGINEERS
 AUGUSTA, GEORGIA

DATE: FEB. 1966
 JOB NO. 655
 DRAWN BY: J.W.C.
 CHECKED BY: S.W.M.
 APPROVED BY: J.A.B.
 REVISION NO. OF 41
 DWG. NO. E-35

REVISION
 1 CHANGED TO AS BUILT DRAWING
 WITH DWG.

