


JONES, NALL & DAVIS  
 SUITE 800  
 57 FORTSMYTH STREET  
 ATLANTA, GA 30303  
 (404) 523-4166

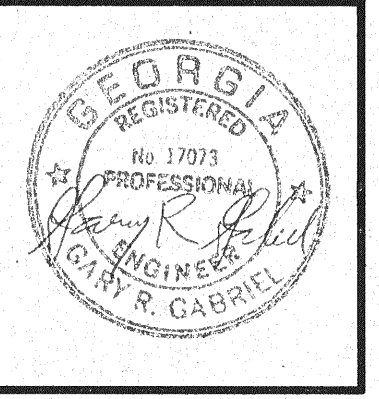


| REVISIONS |  |
|-----------|--|
|           |  |
|           |  |
PROVIDE INDIVIDUAL HEATING AND COOLING PLANTS  
 AT TEN BUILDINGS AND  
 REPLACE ONE CENTRAL PLANT HTW BOILER  
 SERVING THERAPY AT  
 GEORGIA RETARDATION CENTER

BUILDING # 5  
 APPARATUS BUILDING

DATE : 4-16-90  
 M-3.1  
 SHEET 13 OF 53

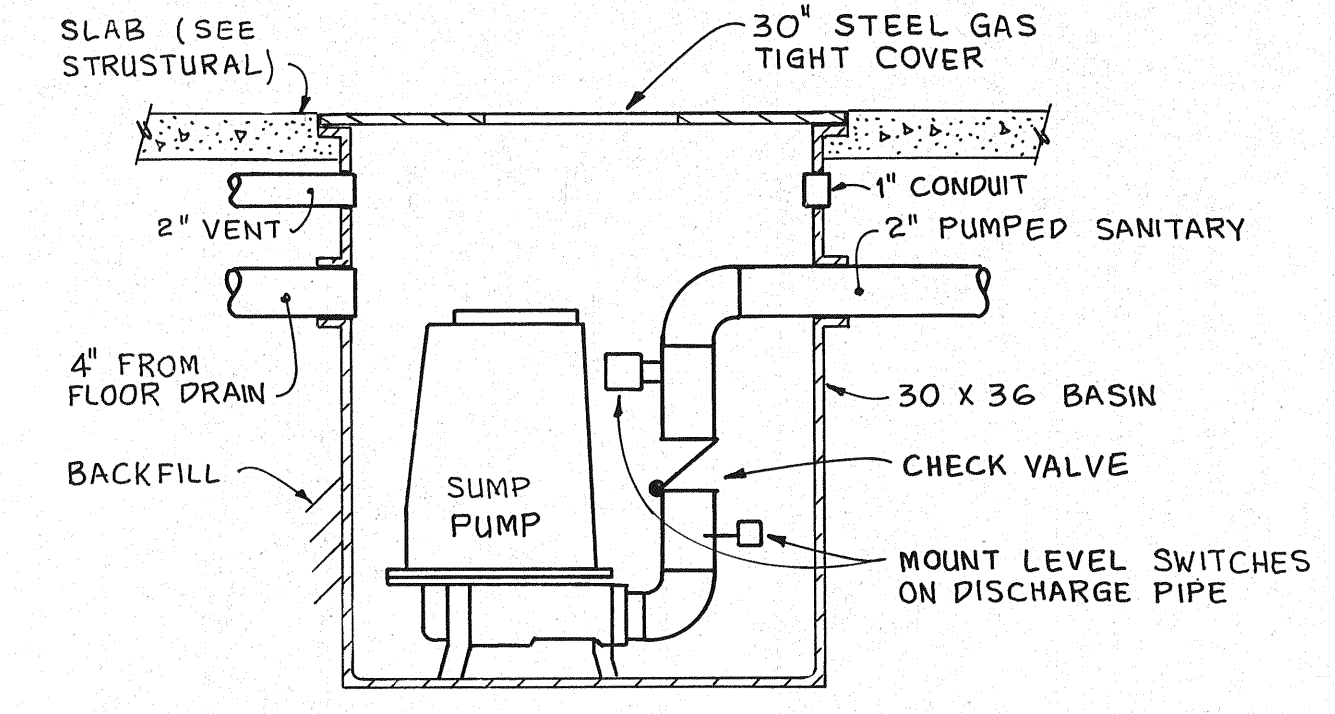

**SUMP PUMP DETAIL**  
 NO SCALE

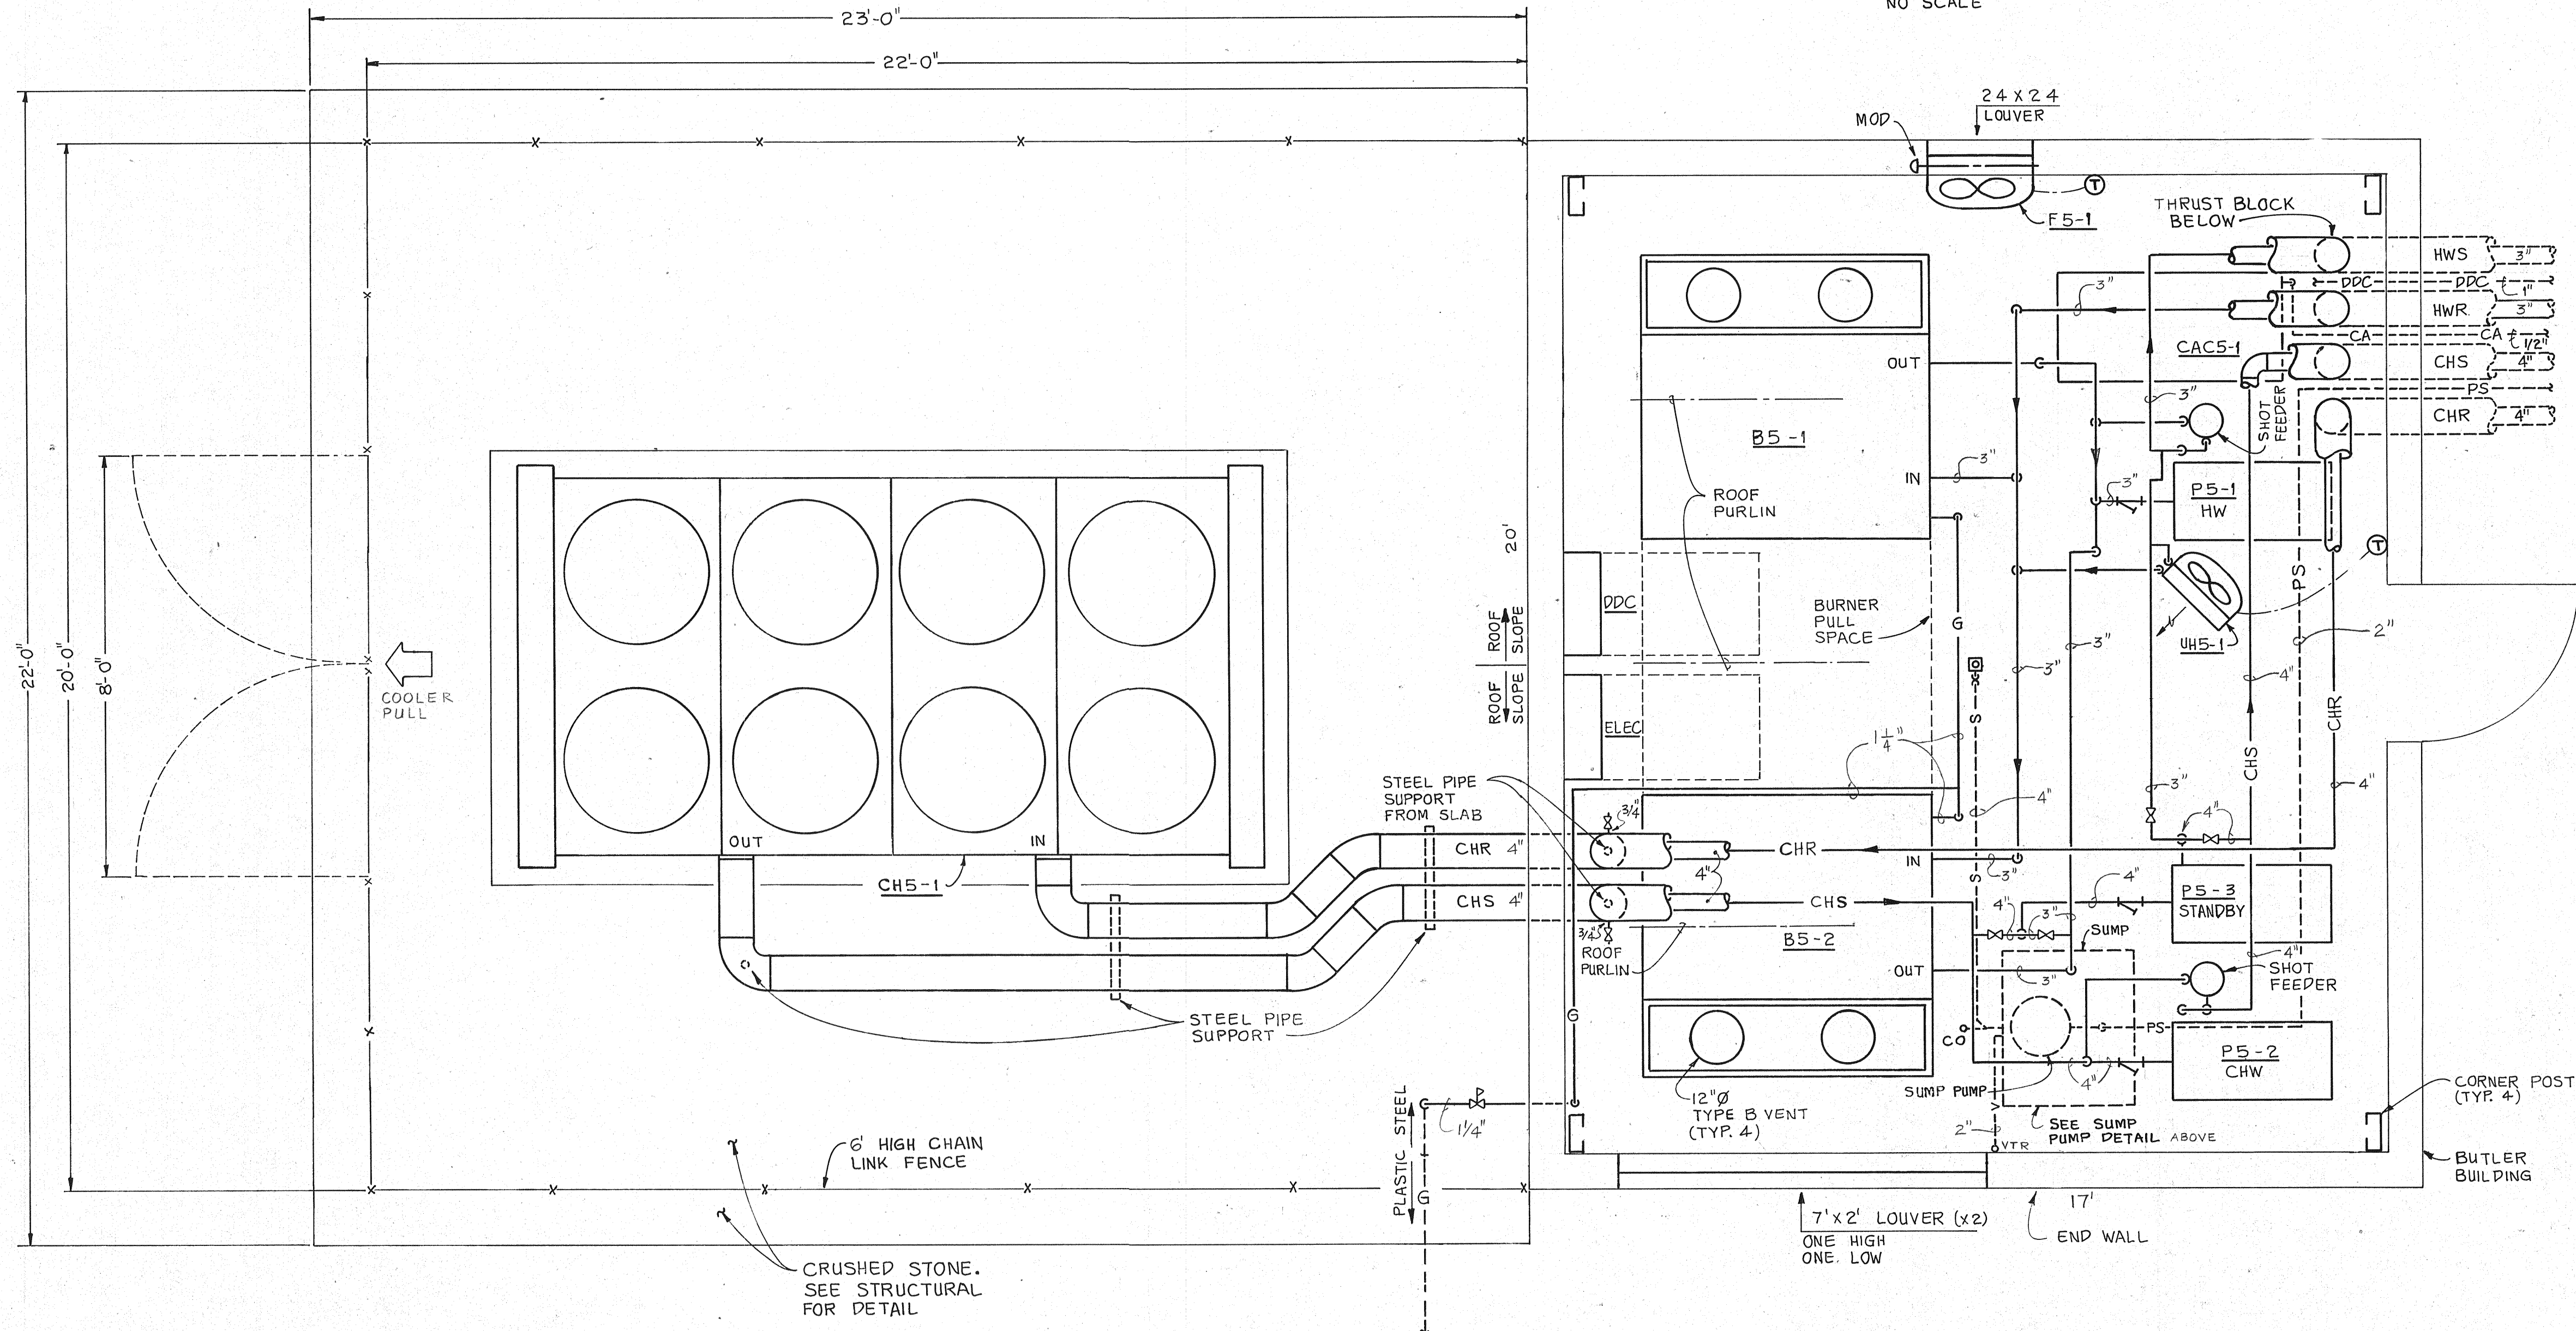

**APPARATUS BUILDING**  
 SCALE : 1/2" = 1'-0"  
 SEE SECTION ON SHEET M-5.1

AS-BUILT DRAWING