

JONES, NALL & DAVIS
 SUITE 800
 57 FORSYTH STREET
 ATLANTA, GA 30303
 (404) 525-4188



REVISIONS

NO.	DESCRIPTION


PROVIDE INDIVIDUAL HEATING AND COOLING PLANTS
 AT TEN BUILDINGS AND
 REPLACE ONE CENTRAL PLANT HTW BOILER
 SERVING THERAPY AT
 GEORGIA RETARDATION CENTER

BUILDING #5
 REHEAT COILS

DATE : 4-16-90

M-3.2

SHEET 14 OF 53

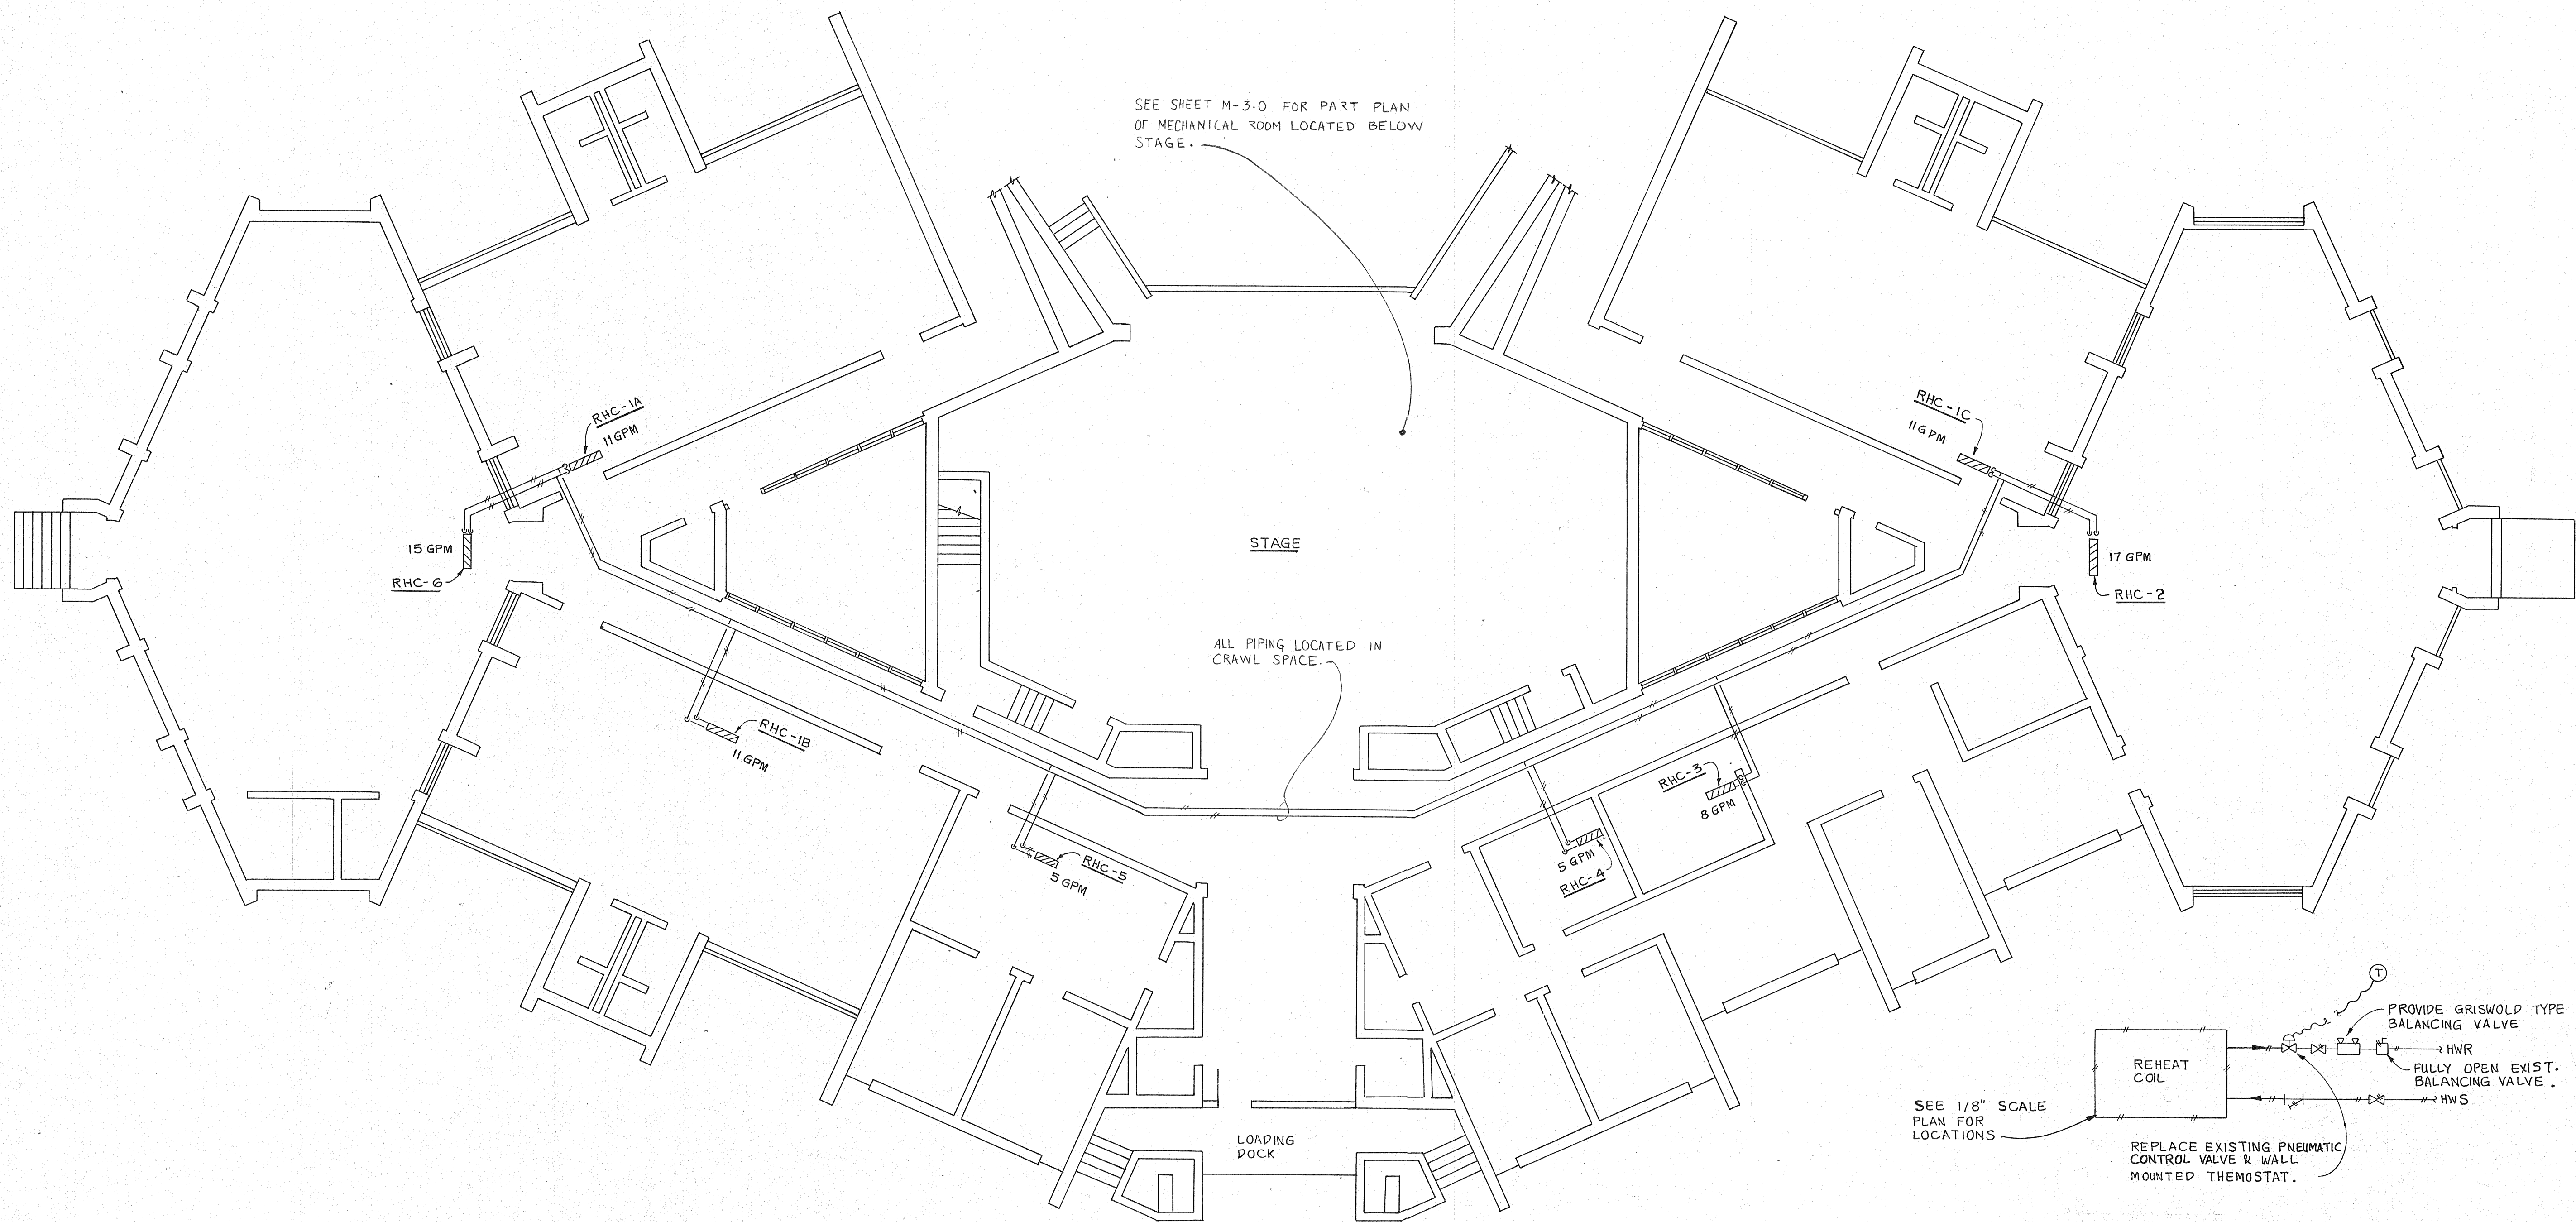

SEE SHEET M-3.0 FOR PART PLAN
 OF MECHANICAL ROOM LOCATED BELOW
 STAGE.

STAGE


ALL PIPING LOCATED IN
 CRAWL SPACE.

LOADING
 DOCK

REHEAT COILS

SCALE : 1/8" = 1'-0"

SEE 1/8" SCALE
 PLAN FOR
 LOCATIONS

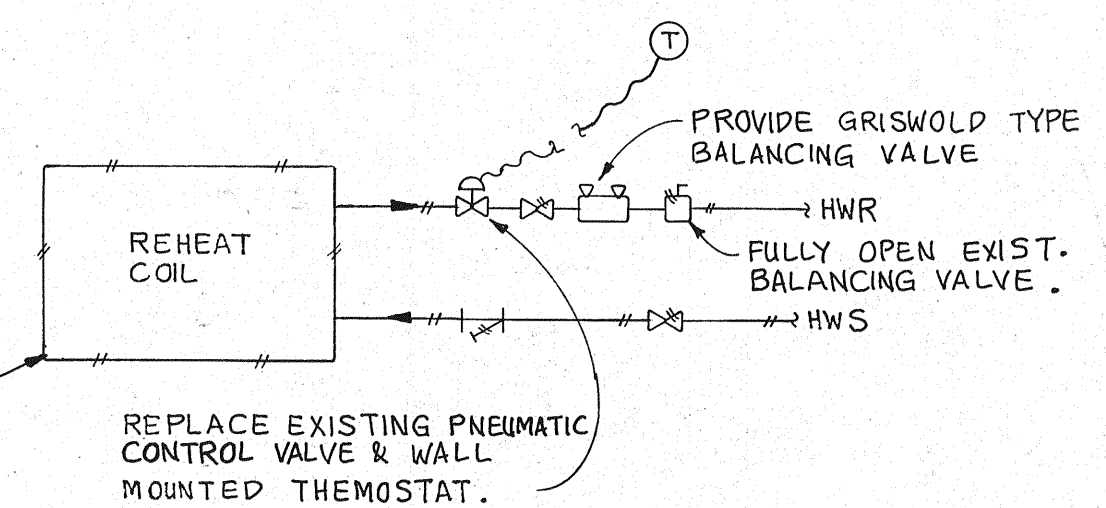

DETAIL

NO SCALE
 NOTES
 1. ALL REHEAT COILS ARE LOCATED
 IN CRAWL SPACE.

AS-BUILT DRAWING

