




TRUSS T-1  
SCALE 3/8" = 1'-0"

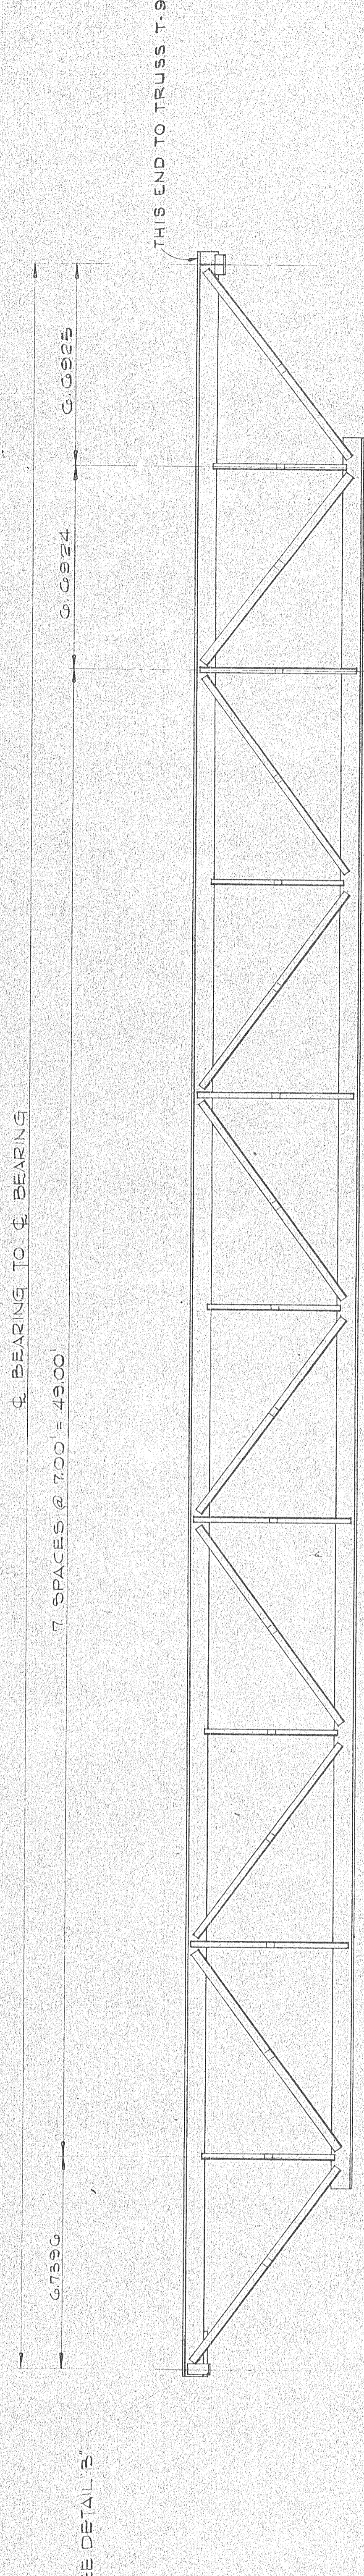


TRUSS T-2  
SCALE 3/8" = 1'-0"

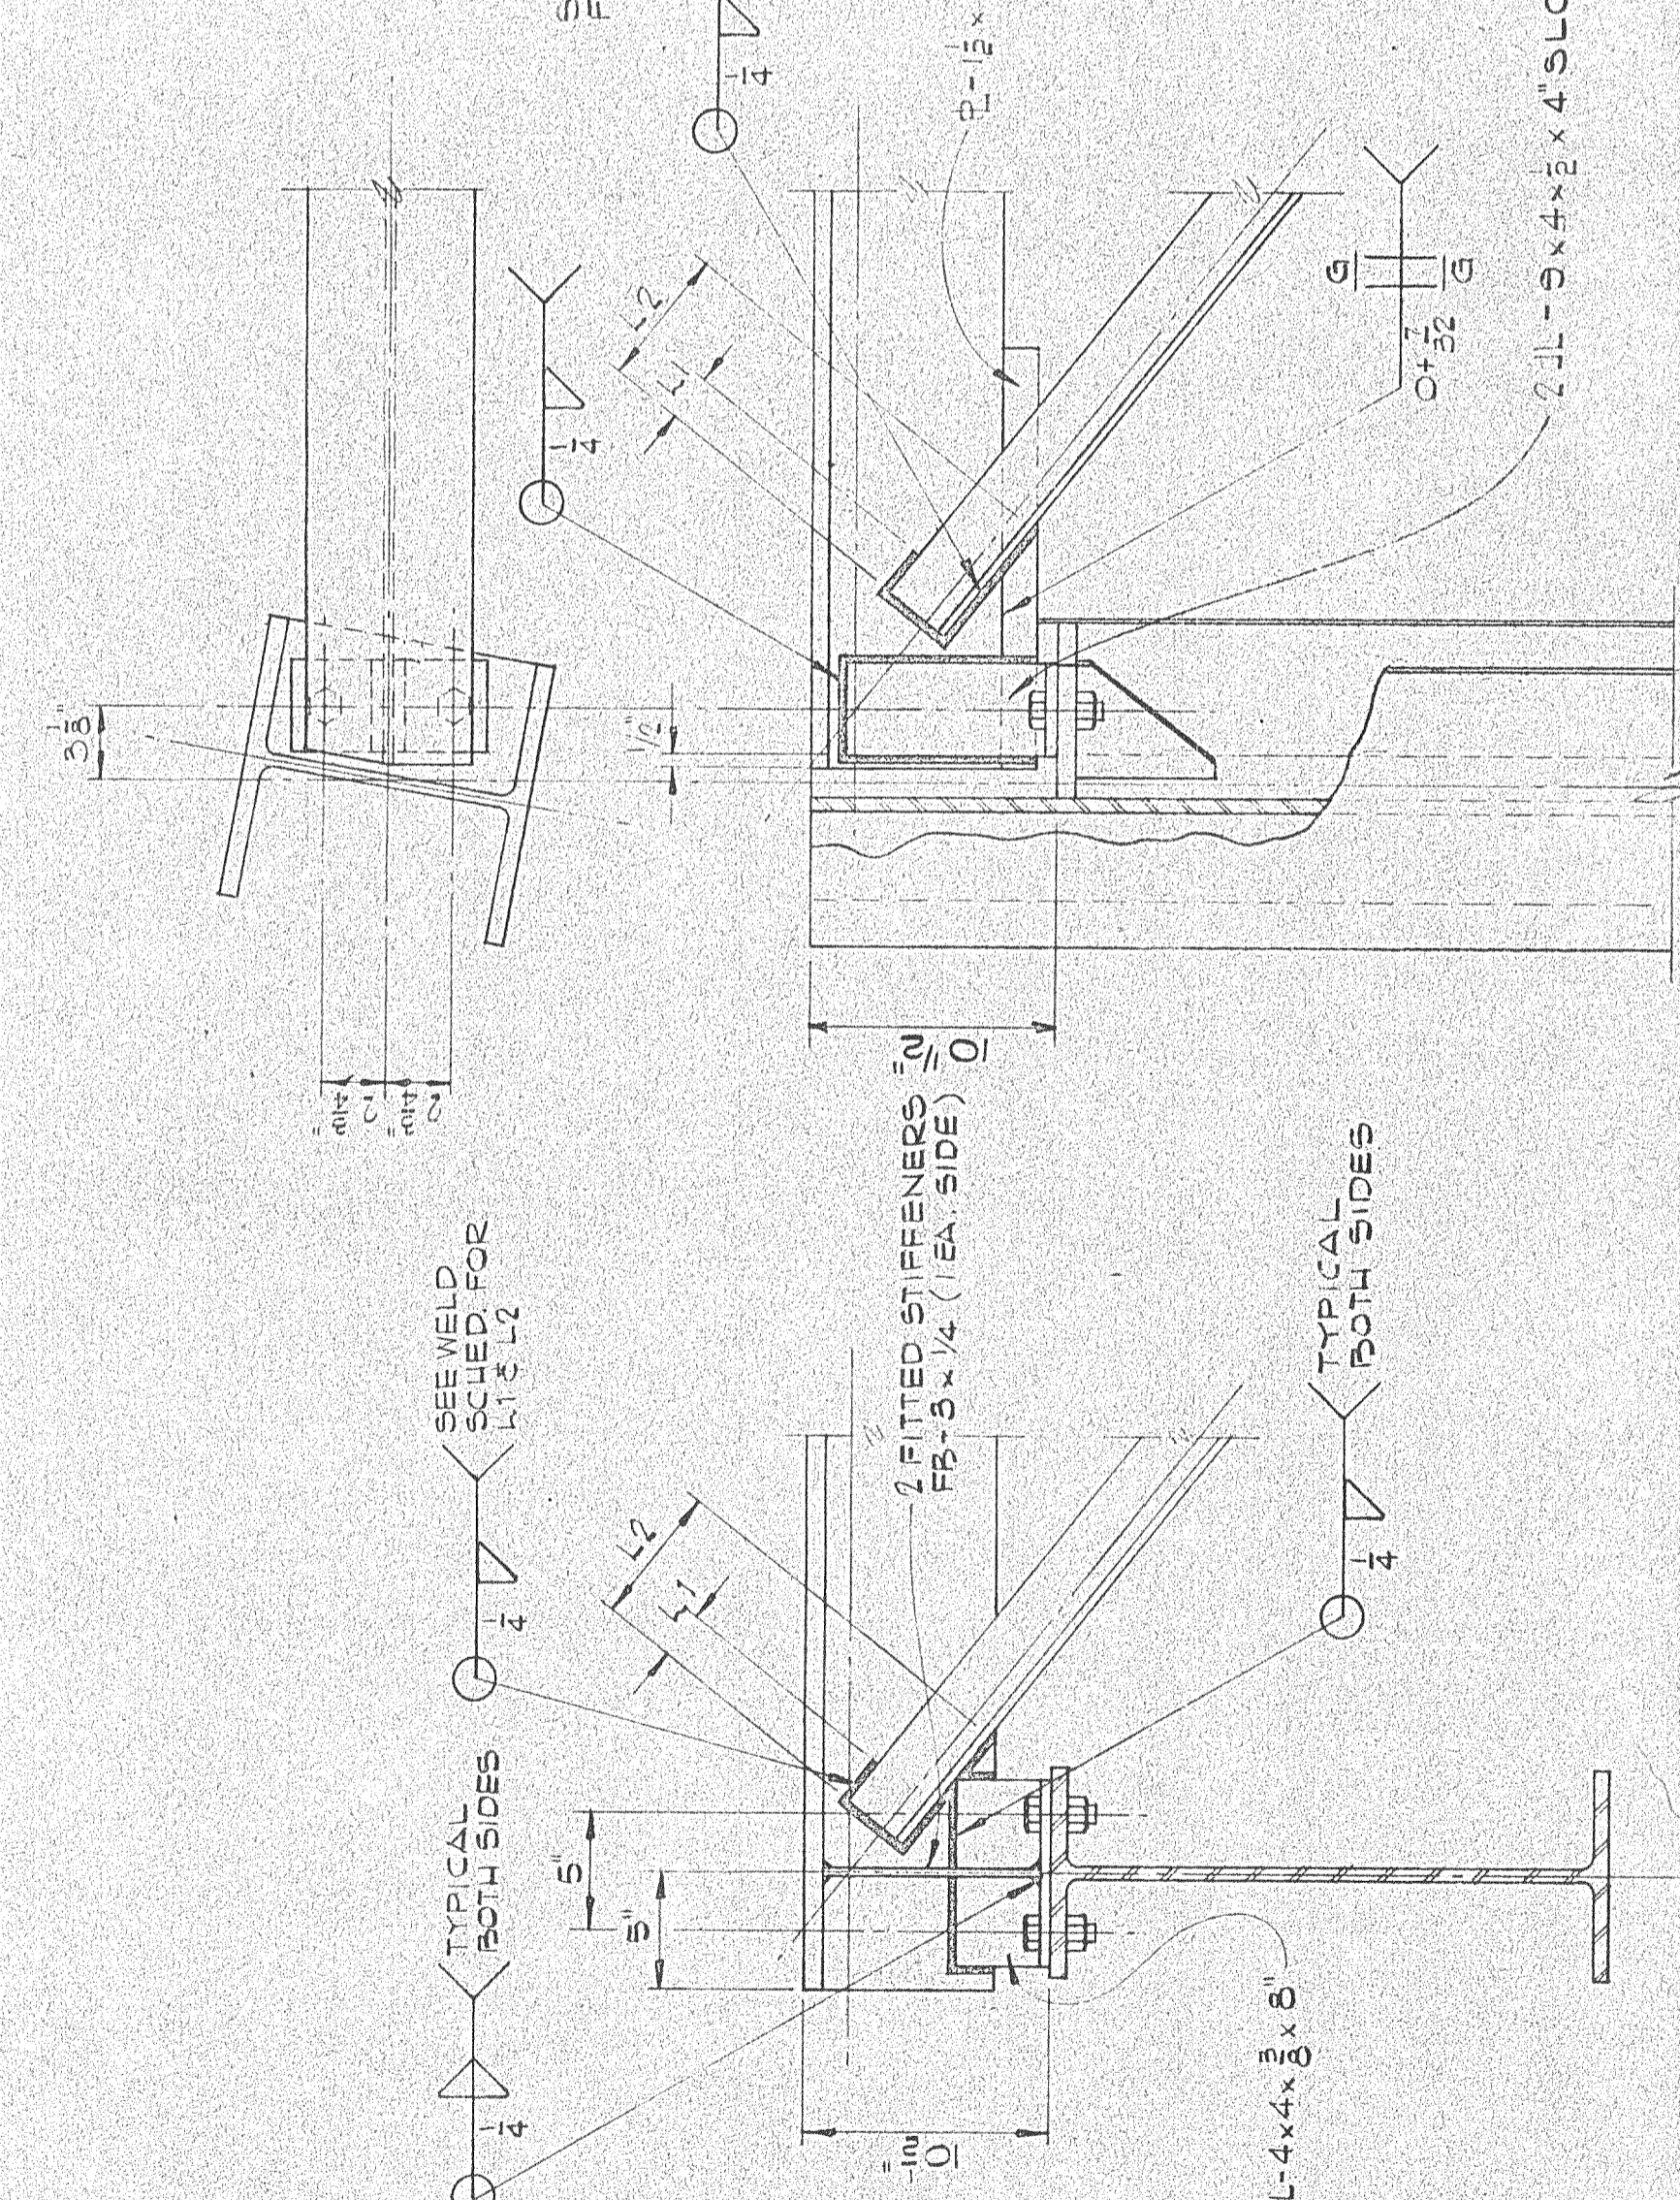


DETAIL A  
SCALE 1/4" = 1'-0"

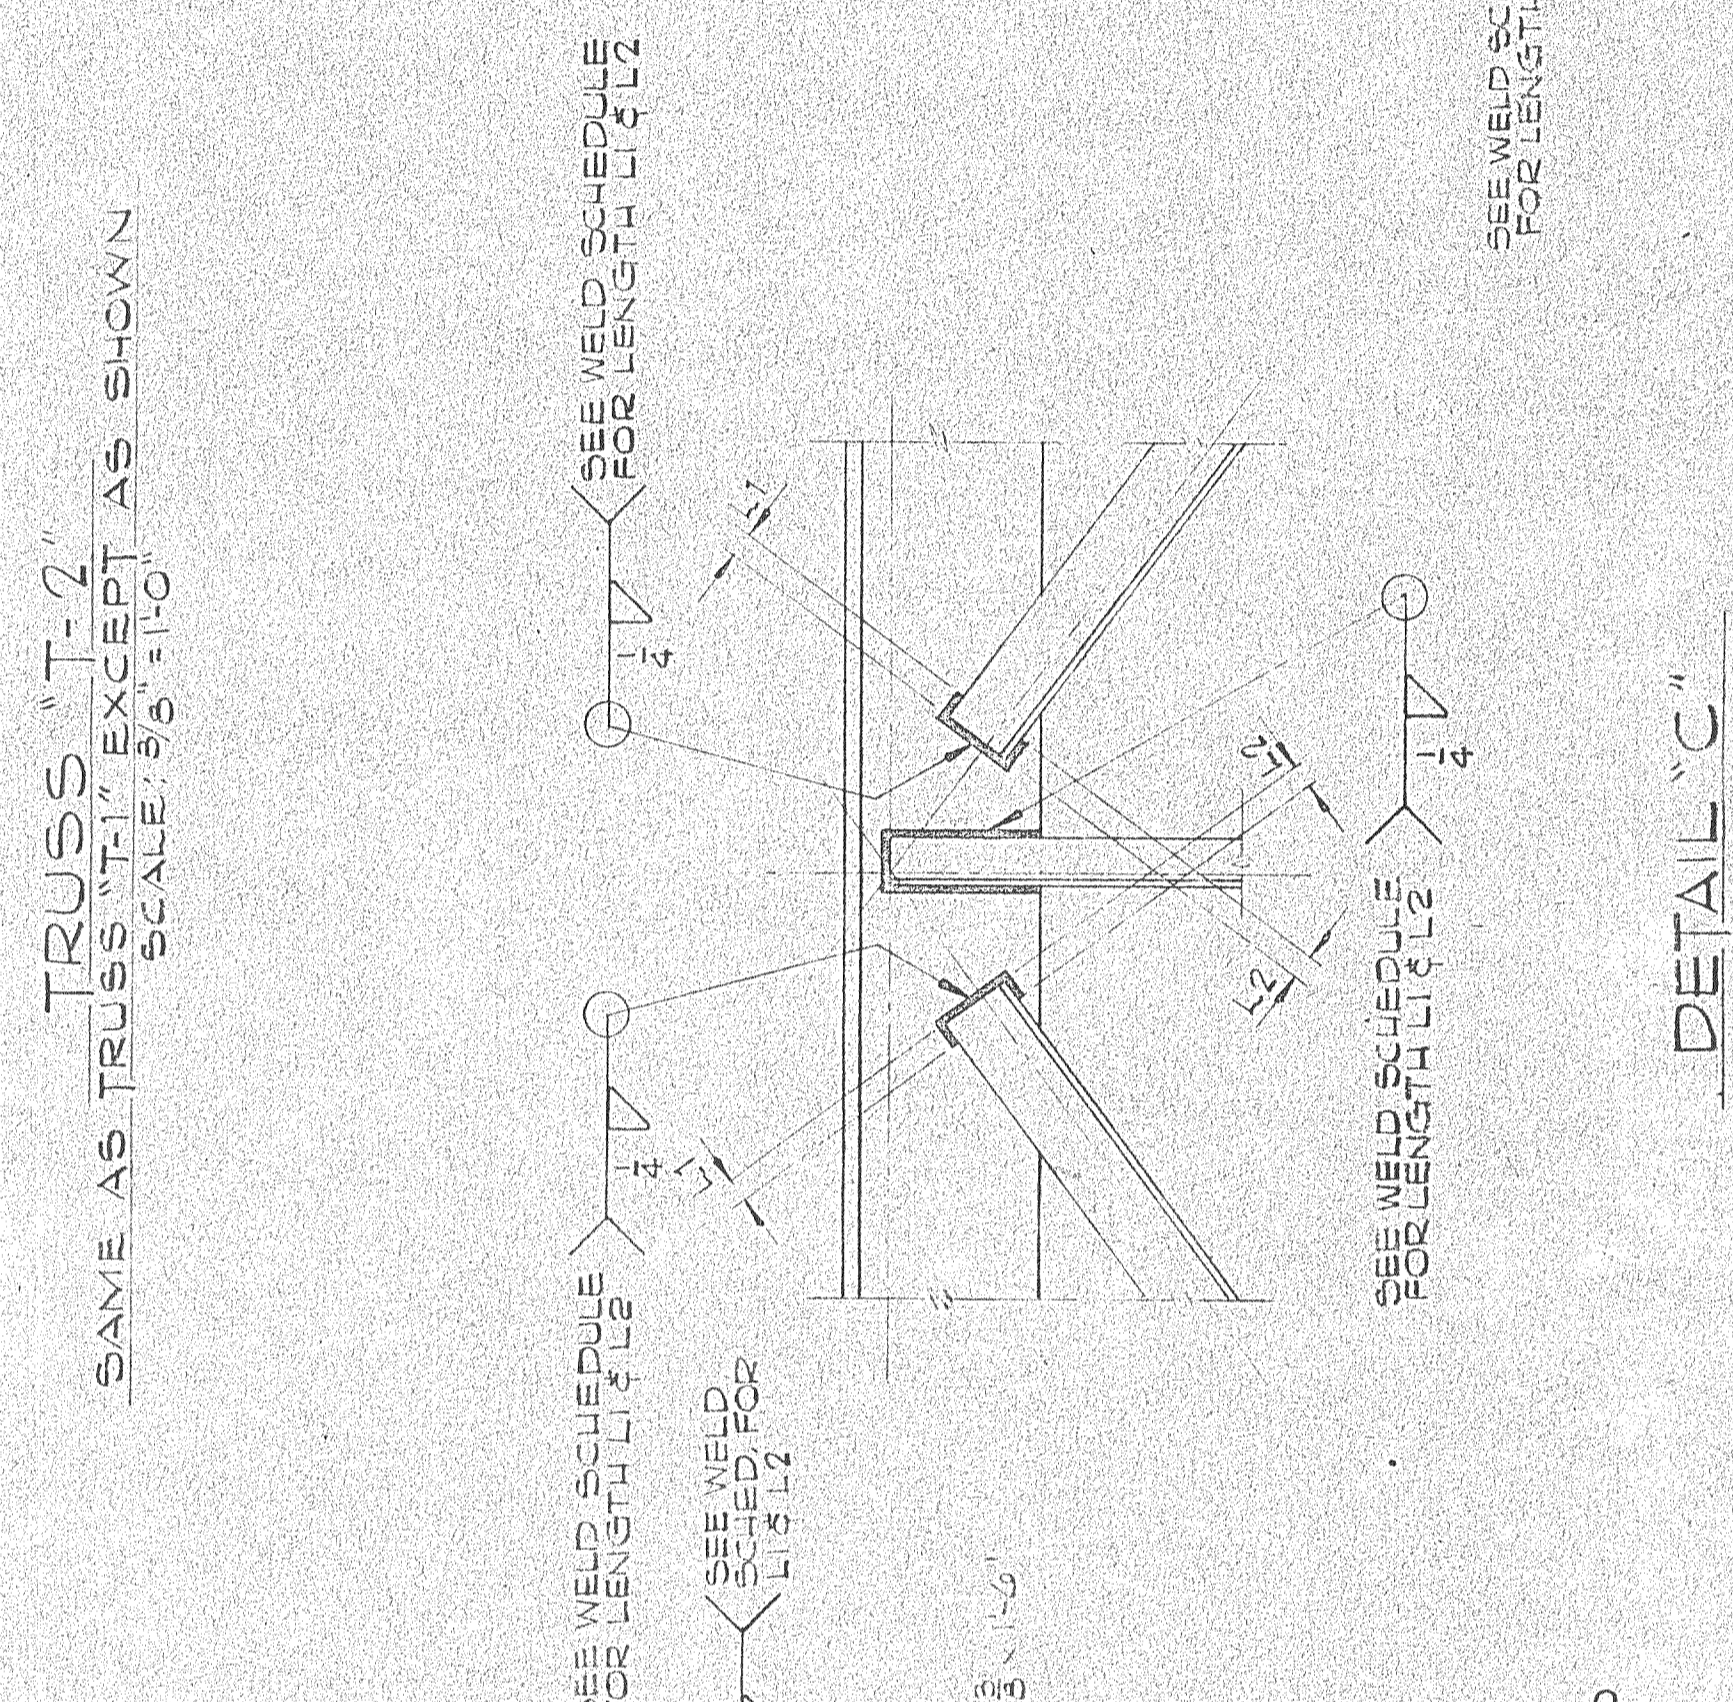

DETAIL B  
SCALE 1/2" = 1'-0"

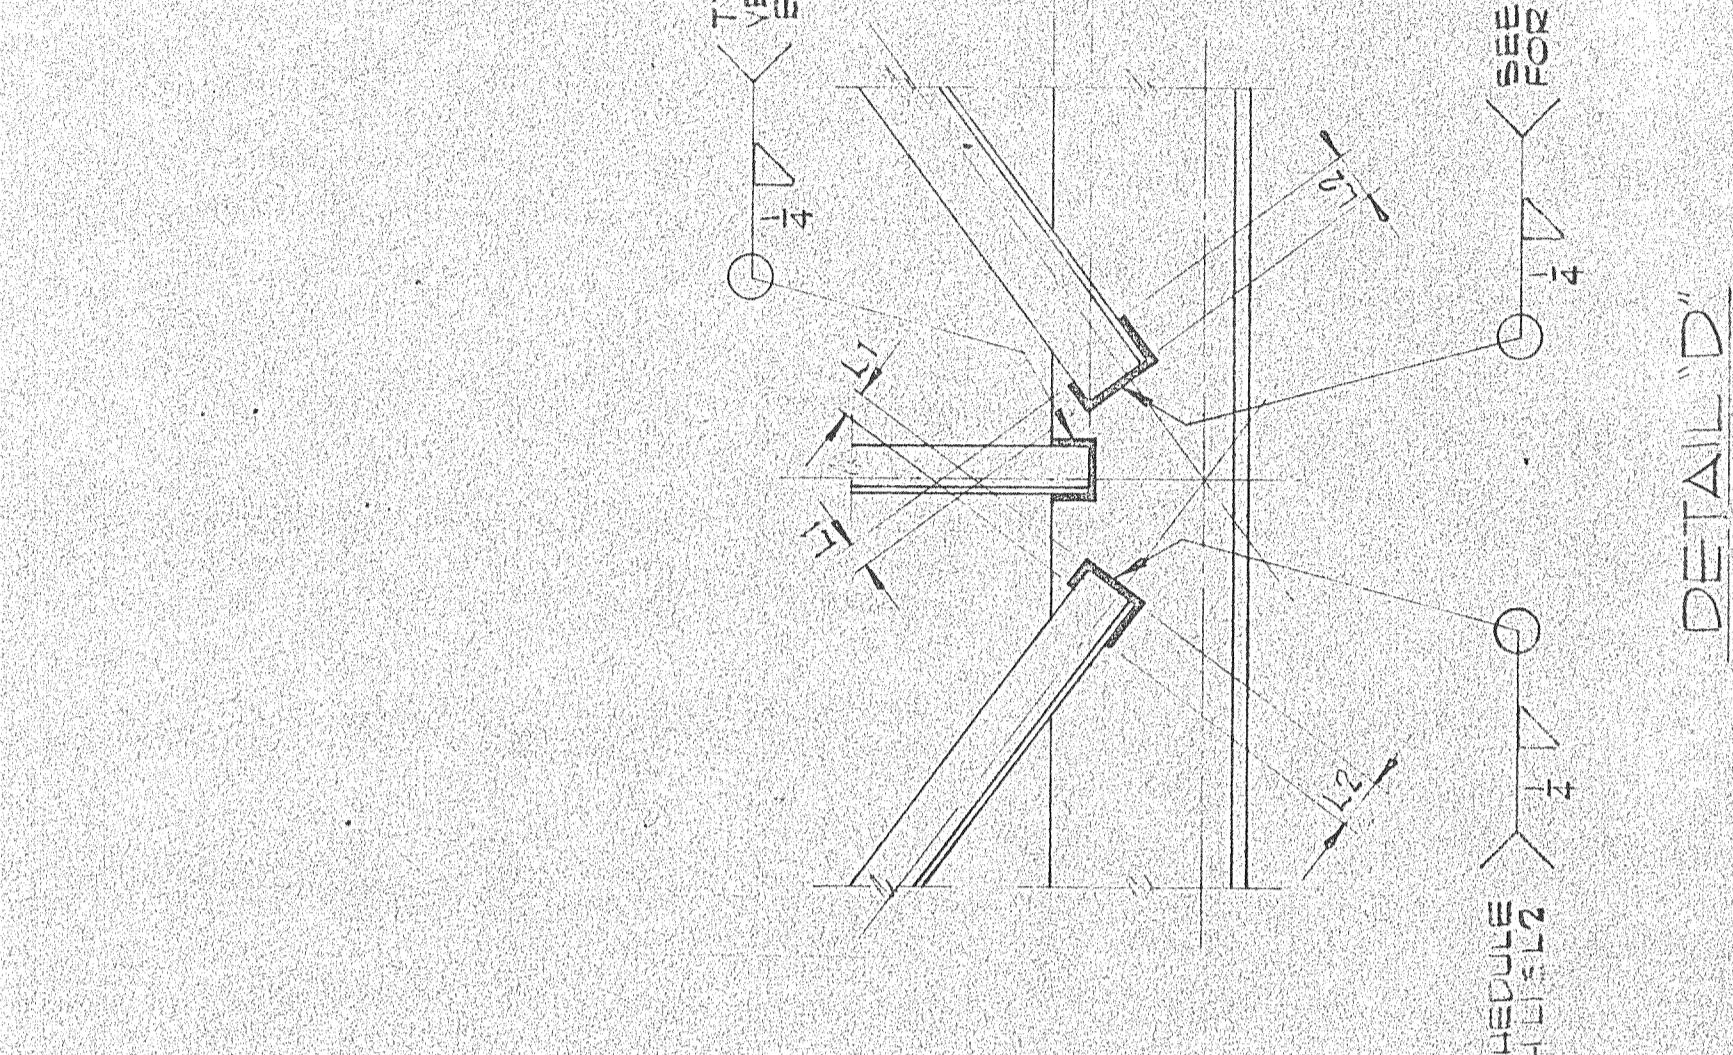

DETAIL C  
SCALE 1/2" = 1'-0"

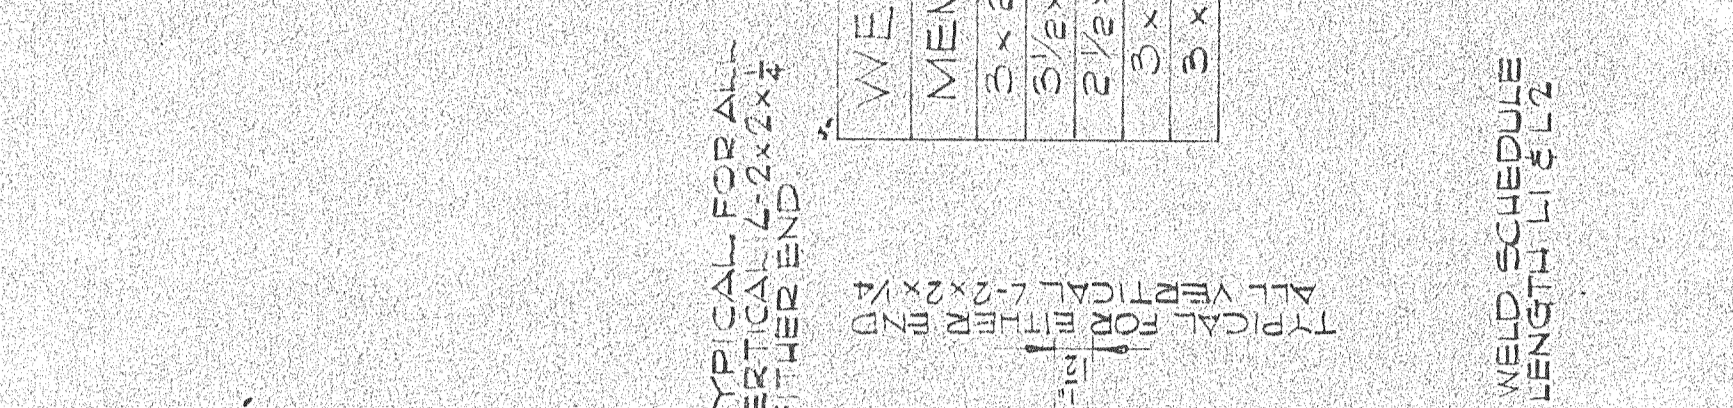

DETAIL D  
SCALE 1/2" = 1'-0"

MEMBER	L1	L2
3 x 2 1/2 x 5/8	3"	0"
2 x 3 x 5/8	1 1/2"	5/2"
3 x 2 x 5/8	1"	2"
3 x 2 x 5/8	1"	2"

CHANGED TO AS BUILT DRAWINGS BY

DATE REVISION

W.H.H.

GEORGIA RETARDATION CENTER  
DEKALB COUNTY, GEORGIA  
DEPARTMENT OF PUBLIC HEALTH

BUILDING L

AUDITORIUM - TRUSSES & CONNECTION DETAILS

ARCHITECTS AND ENGINEERS  
AND ASSOCIATES

APPROVED BY  
R.L.O.  
R.A.B.

DWG. NO. S-58

DATE FEB 1966

REVISION NO. OF 73