


DETAIL "A"
SCALE: 3/8" = 1'-0"
SEE DWG. S-52

21'-2" FOR TRUSS T-10
21'-5 1/8" FOR TRUSS T-11
5 SPACES @ 2'-6" = 10'-0"

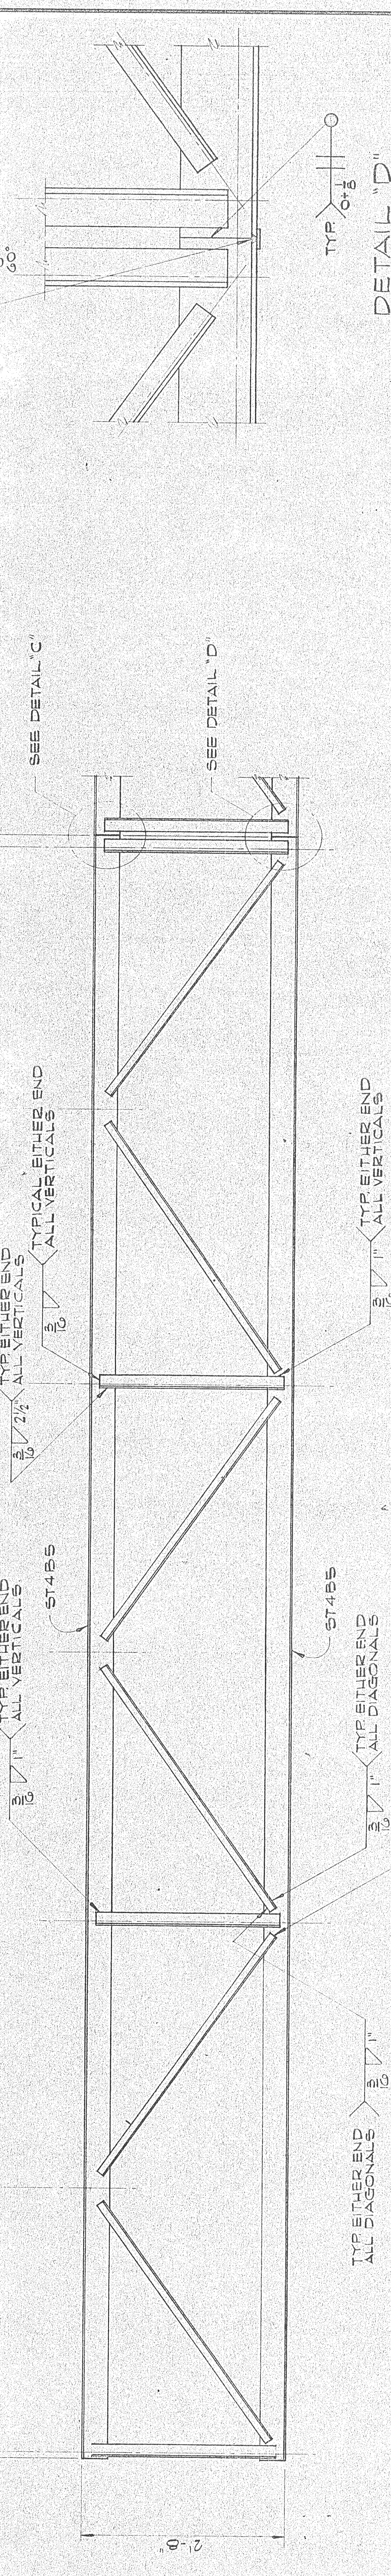


SECTION B-B
SCALE: 1/2" = 1'-0"

DETAIL "C"
SCALE: 3/8" = 1'-0"


NOTE: VERTICALS ARE 2L-1 1/2 x 1/4 x 3/16
ALL DIAGONALS ARE 2L-1 1/2 x 1/4 x 3/16
UNLESS OTHERWISE SPECIFIED

TRUSSES T-10 AND T-11
SCALE: 1" = 1'-0"

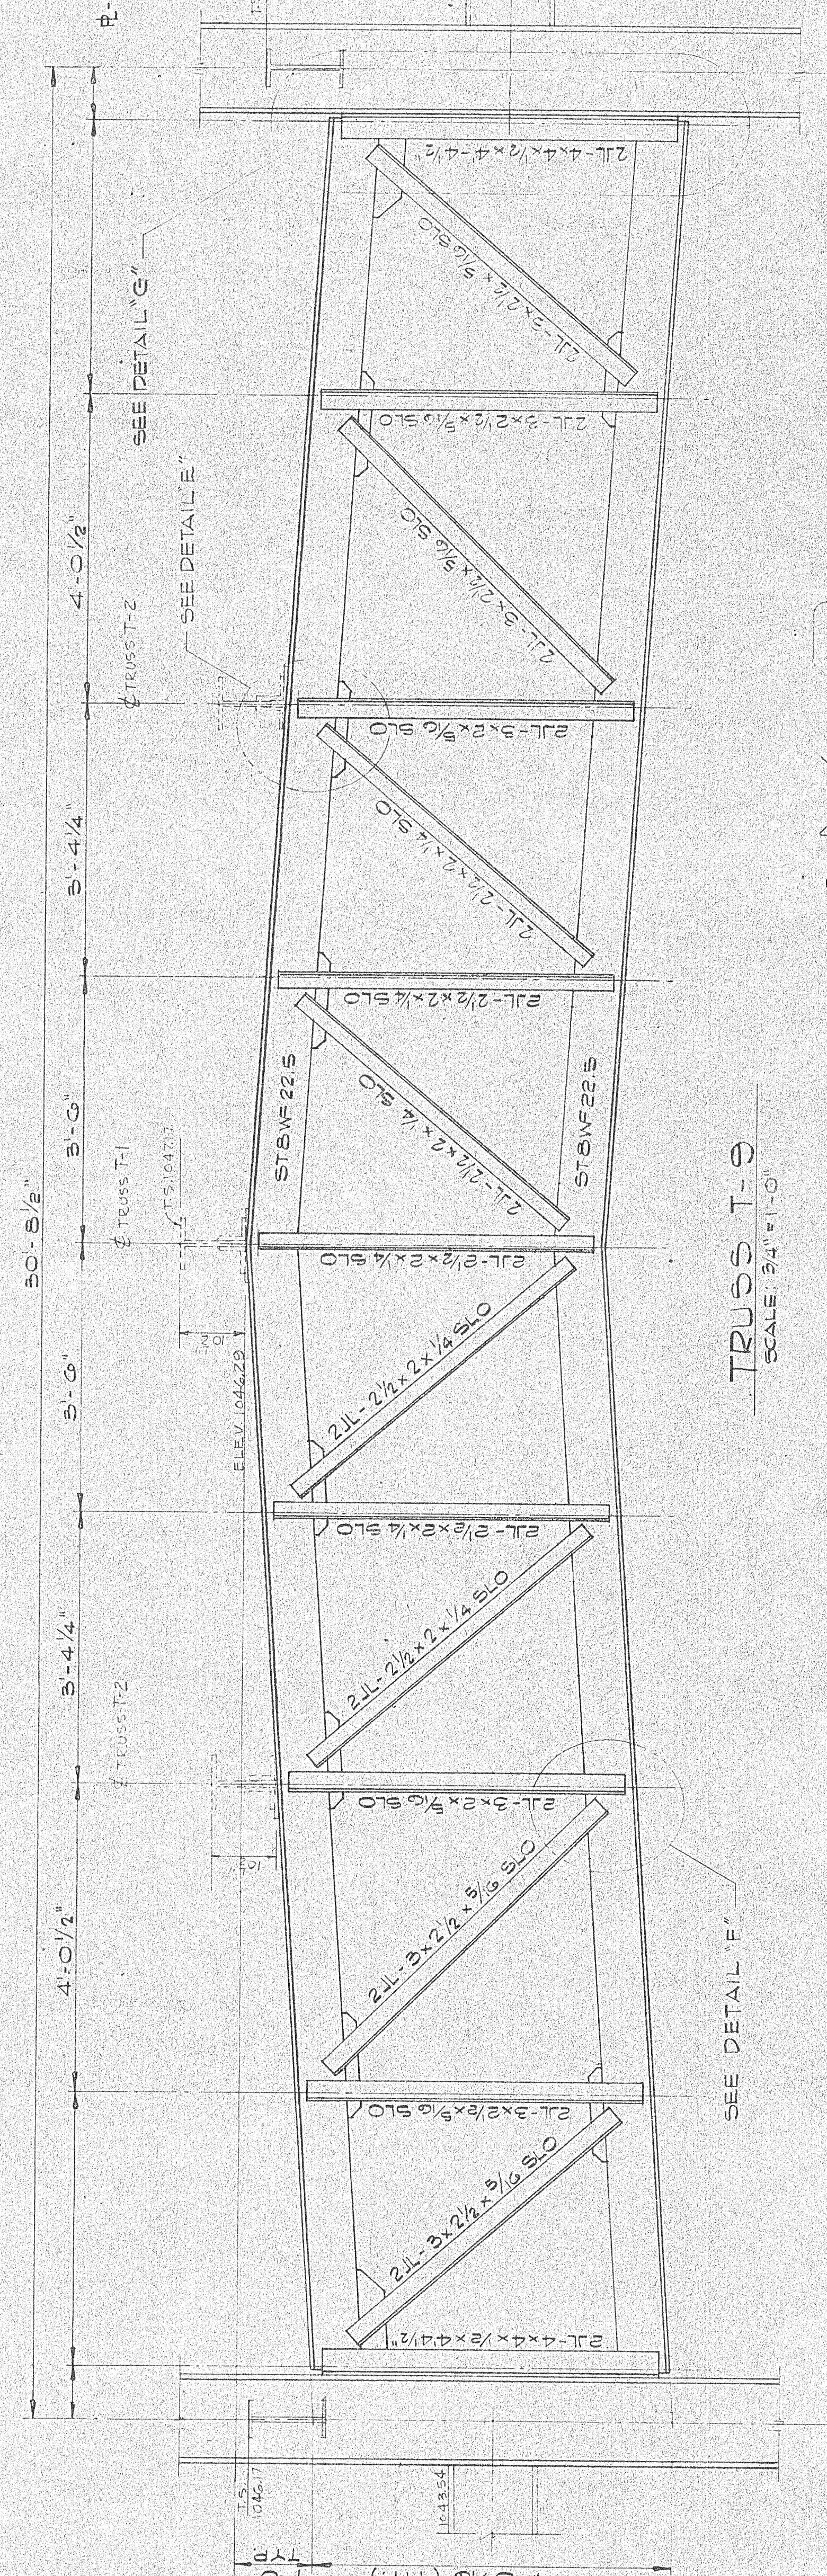


TRUSS T-9
SCALE: 3/4" = 1'-0"

MEMBER	SIZE	L	T
L-5 x 2 1/2 x 3/8	1/4"	1"	4"
L-5 x 5 x 3/8	1/4"	1"	2 1/2"
L-2 1/2 x 2 1/2 x 3/8	3/16"	1"	5 1/2"

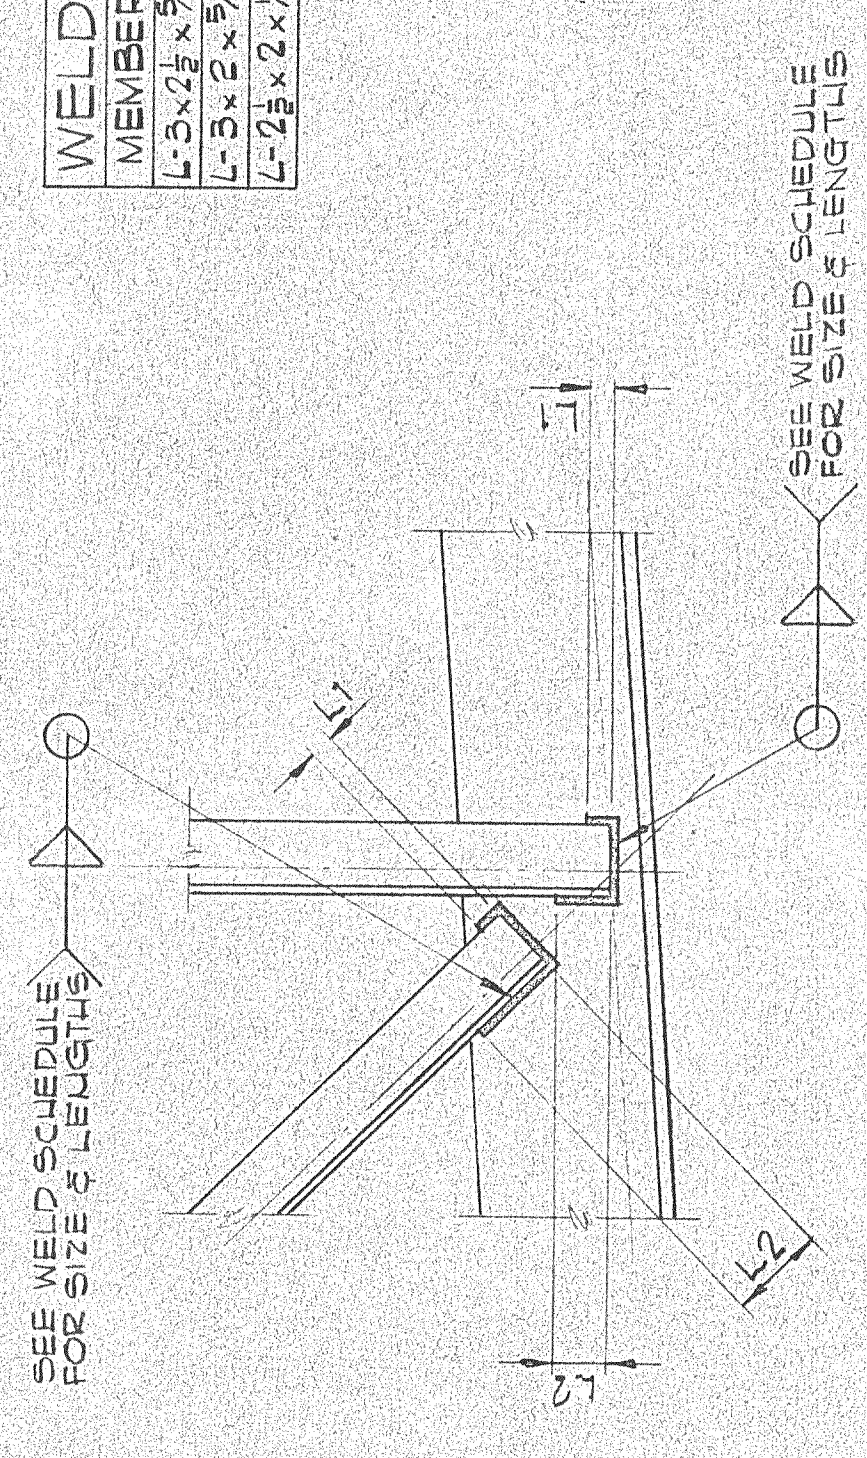

DETAIL "F"
TYPICAL LOWER CHORD CONNECTION
SCALE: 1/2" = 1'-0"

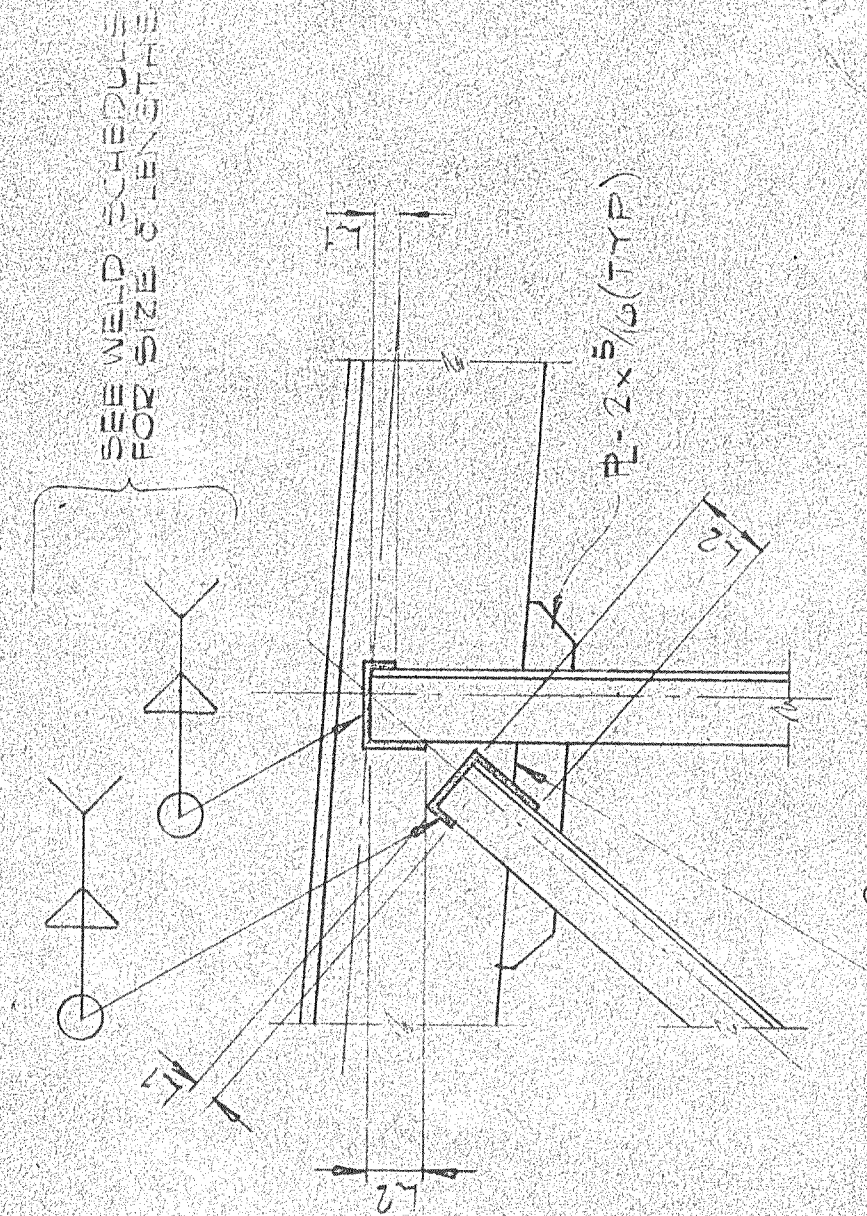

DETAIL "E"
TYPICAL UPPER CHORD CONNECTION
SCALE: 1/2" = 1'-0"

DETAIL "D"
SCALE: 3/8" = 1'-0"

DETAIL "G"
TYPICAL END CONNECTION
SCALE: 1/2" = 1'-0"

8/28/70 1 CHANGED TO AS BUILT PER NOTES WITH DATE REVISION DESCRIPTION

GEORGIA RETARDATION CENTER
DEKALB COUNTY, GEORGIA
GEORGIA DEPARTMENT OF PUBLIC HEALTH

BUILDING L

MISC. TRUSSES & DETAILS

DRN. I.R.A.B. APPROVED BY
DWN. R.I.O.
CHK. I.R.A.B.
JOB 655 DATE FEB. 1966 REVISION NO. OF 73

ARCHITECTS AND ENGINEERS
AND ASSOCIATES
AUGUSTA, GEORGIA

